


1 LOCATION OF WATER WELL: Fraction SE 1/4 SE 1/4 SW 1/4 Section Number 19 Township Number T 22 S Range Number R 2 E/W  
 County: Walton/Harvey  
 Distance and direction from nearest town or city street address of well if located within city?  
100 Main Street Walton, Kansas

2 WATER WELL OWNER: Walton-Farmers Coop  
 RR#, St. Address, Box #: 100 Main Street Board of Agriculture, Division of Water Resources  
 City, State, ZIP Code: Walton, Kansas Application Number:

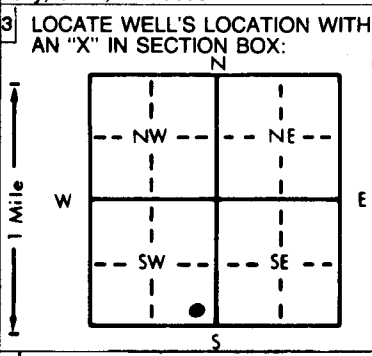

4 DEPTH OF COMPLETED WELL: 65' ft. ELEVATION:  
 Depth(s) Groundwater Encountered 1. 9' ft. 2. ft. 3. ft.  
 WELL'S STATIC WATER LEVEL: 9.25 ft. below land surface measured on mo/day/yr 10-13-98  
 Pump test data: Well water was ft. after hours pumping gpm  
 Est. Yield gpm; Well water was ft. after hours pumping gpm  
 Bore Hole Diameter: 8 1/2" in. to 15' ft., and in. to ft.  
 WELL WATER TO BE USED AS:  
 5 Public water supply 8 Air conditioning 11 Injection well  
 1 Domestic 3 Feedlot 6 Oil field water supply 9 Dewatering 12 Other (Specify below)  
 2 Irrigation 4 Industrial 7 Lawn and garden only 10 Monitoring well  
 Was a chemical/bacteriological sample submitted to Department? Yes No X; If yes, mo/day/yr sample was submitted  
 Water Well Disinfected? Yes No

5 TYPE OF BLANK CASING USED:  
 1 Steel 3 RMP (SR) 5 Wrought iron 8 Concrete tile CASING JOINTS: Glued Clamped  
2 PVC 4 ABS 6 Asbestos-Cement 9 Other (specify below) Welded  
 7 Fiberglass Threaded X  
 Blank casing diameter 2.375 in. to 5' ft., Dia. in. to ft., Dia. in. to ft.  
 Casing height above land surface Full 1/2 in., weight lbs./ft. Wall thickness or gauge No. 30-13 Sch 40  
 TYPE OF SCREEN OR PERFORATION MATERIAL:  
 1 Steel 3 Stainless steel 5 Fiberglass 8 RMP (SR) 10 Asbestos-cement  
 2 Brass 4 Galvanized steel 6 Concrete tile 9 ABS 11 Other (specify) 12 None used (open hole)  
 SCREEN OR PERFORATION OPENINGS ARE:  
 1 Continuous slot 3 Mill slot 5 Gauzed wrapped 8 Saw cut 11 None (open hole)  
 2 Louvered shutter 4 Key punched 6 Wire wrapped 9 Drilled holes  
 7 Torch cut 10 Other (specify)  
 SCREEN-PERFORATED INTERVALS: From 15' ft. to 5' ft., From ft. to ft.  
 From ft. to ft., From ft. to ft.  
 GRAVEL PACK INTERVALS: From 15' ft. to 4' ft., From ft. to ft.  
 From ft. to ft., From ft. to ft.

6 GROUT MATERIAL:  
 1 Neat cement 2 Cement grout 3 Bentonite 4 Other  
 Grout Intervals: From 4' ft. to 3' ft., From 3' ft. to 0' ft., From ft. to ft.  
 What is the nearest source of possible contamination:  
 1 Septic tank 4 Lateral lines 7 Pit privy 10 Livestock pens 14 Abandoned water well  
 2 Sewer lines 5 Cess pool 8 Sewage lagoon 1 Fuel storage 15 Oil well/Gas well  
 3 Watertight sewer lines 6 Seepage pit 9 Feedyard 12 Fertilizer storage 16 Other (specify below)  
 13 Insecticide storage  
 Direction from well? Southeast How many feet? 100'

FROM	TO	LITHOLOGIC LOG	FROM	TO	PLUGGING INTERVALS
0	1	grass, topsoil			
1	10	Clay, dark brown, dry, hard, rust mottled, faint odor moist, firm, gravel, caliche			
10	15	shale, moist, firm, silty, gravelly, caliche, weathered, mod. odor, ls fragments, white chalky, dry, hard, no odor B.O.H. 15'			
					Fl.mt. OK'D by Don Taylor

7 CONTRACTOR'S OR LANDOWNER'S CERTIFICATION: This water well was (1) constructed (2) reconstructed, or (3) plugged under my jurisdiction and was completed on (mo/day/year) 10-5-98 and this record is true to the best of my knowledge and belief. Kansas Water Well Contractor's License No. 539 This Water Well Record was completed on (mo/day/yr) 11-6-98 under the business name of JB Environmental Drilling by (signature) James Beck

OFFICE USE ONLY  
T  
R  
EW  
SEC.  
1/4  
1/4  
1/4