


1 LOCATION OF WATER WELL: County: Harvey Fraction NW 1/4 NE 1/4 SE 1/4 Section Number 19 Township Number T 22 S Range Number R 2 E/W

Distance and direction from nearest town or city street address of well if located within city? 5730 E. Hwy 50, Walton

2 WATER WELL OWNER: Hilltop Convenience Store RR#, St. Address, Box #: 5730 E. Highway 50 City, State, ZIP Code: Walton, Kansas 67151 Board of Agriculture, Division of Water Resources Application Number:

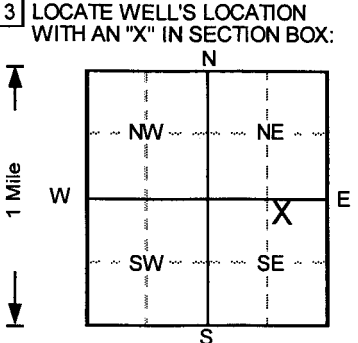

3 LOCATE WELL'S LOCATION WITH AN 'X' IN SECTION BOX: 4 DEPTH OF COMPLETED WELL: 14 ft. ELEVATION: 1544.63. WELL'S STATIC WATER LEVEL: 5.56 ft. below land surface measured on 2/23/2007. Pump test data: Well water was NA ft. after NA hours pumping. Est. Yield NA gpm. Bore Hole Diameter 8 in. to 14 in. WELL WATER TO BE USED AS: 10 Monitoring well.

5 TYPE OF BLANK CASING USED: 2 PVC. Blank casing diameter 2 in. to 4 ft. Dia. Casing height above land surface -6.48 in. TYPE OF SCREEN OR PERFORATION MATERIAL: 7 PVC. SCREEN OR PERFORATION OPENINGS ARE: 3 Mill slot. SCREEN-PERFORATED INTERVALS: From 4 ft. to 14 ft. GRAVEL PACK INTERVALS: From 3 ft. to 14 ft.

6 GROUT MATERIAL: 4 Other Concrete. Grout intervals: From 0 ft. to 1 ft. What is the nearest source of possible contamination: 13 Insecticide storage. Direction from well? How many feet?

Table with columns: FROM, TO, LITHOLOGIC LOG, FROM, TO, PLUGGING INTERVALS. Rows describe geological layers: Clay, gravel, sand (fill) - no odor; Clay, tr. gravel, plastic, moist, no odor, Brown; Shale, weathered, no odor, Olive mottled Yello; Shale, v. firm, Pale Green to Grayish Green; Shale, v. firm to hard, Grayish Green.

7 CONTRACTOR'S OR LANDOWNER'S CERTIFICATION: This water well was (1) constructed, (2) reconstructed, or (3) plugged under my jurisdiction and was completed on (mo/day/year) 2/21/2007 and this record is true to the best of my knowledge and belief. Kansas Water Well Contractor's License No. 527. This Water Well Record was completed on (mo/day/yr) 3/16/2007 under the business name of GeoCore, Inc. by (signature) Dan Kol