


1 LOCATION OF WATER WELL: County: Harvey	Fraction NE ¼ NW ¼ SE ¼	Section Number 19	Township Number T 22 S	Range Number R 2 E
--	-----------------------------------	-----------------------------	----------------------------------	------------------------------

Distance and direction from nearest town or city street address of well if located within city?
5730 East Hwy 50, Walton, Kansas

2 WATER WELL OWNER: Rick VanRossun RR#, St. Address, Box #: 5730 E. Hwy 50, Walton City, State, ZIP Code: Walton, Ks 67151	Board of Agriculture, Division of Water Resources Application Number:
---	--

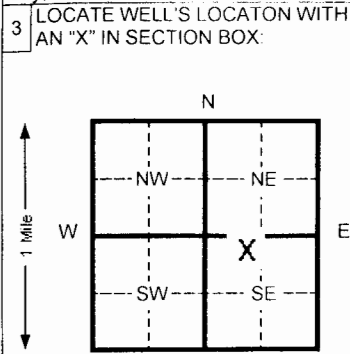

4 DEPTH OF COMPLETED WELL: 20 ft. ELEVATION:	Depth(s) Groundwater Encountered 11.5 ft. 2 ft. 3 ft. Ft.
WELL'S STATIC WATER LEVEL: 9.3 ft. below land surface measured on mo/day/yr 09/04/08	
Pump test data: Well water was _____ Ft. after _____ hours pumping _____ Gpm	
Est. Yield _____ Gpm: Well water was _____ Ft. after _____ Hours pumping _____ Gpm	
Bore Hole Diameter 8.625 In. to 20 ft. and _____ in. to _____ Ft.	
WELL WATER TO BE USED AS:	5 Public water supply 8 Air conditioning 11 Injection well 1 Domestic 3 Feed lot 6 Oil field water supply 9 Dewatering 12 Other (Specify below)
2 Irrigation 4 Industrial 7 Lawn and garden (domestic) 10 Monitoring well MW-10	
Was a chemical/bacteriological sample submitted to Department? Yes _____ No X If yes, mo/day/yr sample was Submitted _____	Water Well Disinfected? Yes _____ No X

5 TYPE OF BLANK CASING USED:	5 Wrought Iron 8 Concrete tile CASING JOINTS: Glued _____ Clamped _____
1 Steel 3 RMP (SR) 6 Asbestos-Cement 9 Other (specify below) _____ Welded _____	
2 PVC 4 ABS 7 Fiberglass _____ Threaded _____ X	
Blank casing diameter 2 in. to 10 Ft. Dia _____ in. to _____ ft., Dia _____ in. to _____ ft.	
Casing height above land surface FLUSH in., weight SCH 40 Lbs./ft. Wall thickness or gauge No. _____	
TYPE OF SCREEN OR PERFORATION MATERIAL:	7 PVC 10 Asbestos-cement
1 Steel 3 Stainless steel 5 Fiberglass 8 RMP (SR) 11 Other (specify) _____	
2 Brass 4 Galvanized steel 6 Concrete tile 9 ABS 12 None used (open hole) _____	
SCREEN OR PERFORATION OPENINGS ARE:	5 Gauzed wrapped 8 Saw cut 11 None (open hole)
1 Continuous slot 3 Mill slot 6 Wire wrapped 9 Drilled holes	
2 Louvered shutter 4 Key punched 7 Torch cut 10 Other (specify) _____	
SCREEN-PERFORATED INTERVALS: From 10 ft. to 20 ft. From _____ ft. to _____ ft.	
SAND PACK INTERVALS: From 8 ft. to 20 ft. From _____ ft. to _____ ft.	

6 GROUT MATERIAL:	1 Neat cement 2 Cement grout 3 Bentonite 4 Other _____
Grout Intervals From 3 0 ft. to 2 Ft. From 2 2 Ft. to 8 ft. From _____ ft. to _____ ft.	
What is the nearest source of possible contamination:	10 Livestock pens 14 Abandoned water well
1 Septic tank 4 Lateral lines 7 Pit privy 11 Fuel storage 15 Oil well/ Gas well	
2 Sewer lines 5 Cess pool 8 Sewage lagoon 12 Fertilizer storage 16 Other (specify below)	
3 Watertight sewer lines 6 Seepage pit 9 Feedyard 13 Insecticide storage Contaminated Site	

FROM	TO	CODE	LITHOLOGIC LOG	FROM	TO	PLUGGING INTERVALS
0	4.5		Clay, hard, dry, yellow brown			
4.5	6		Clay, hard, dry, olive gray			
6	20		Clay, hard, dry, yellow gray			
20	TD		End of borehole			

7 CONTRACTOR'S OR LANDOWNER'S CERTIFICATION: This water well was (x) constructed, (2) reconstructed, or (3) plugged under my jurisdiction and was Completed on (mo/day/yr) 09/04/08	And this record is true to the best of my knowledge and belief. Kansas Water Well Contractor's License No. 585 This Water Well Record was completed on (mo/day/yr) 10/04/08
under the business name of Associated Environmental, Inc.	By (signature) Bradley J Johnson

INSTRUCTIONS: Please fill in blanks and circle the correct answers. Send three copies to Kansas Department of Health and Environment, Bureau of Water, Topeka, Kansas 66620-0001 Telephone 913-296-5545. Send one to WATER WELL OWNER and retain one for your records.

OFFICE USE ONLY

T
R

SEC