


5725 N. Broadway – Wichita

Application Number:

1333.33 (TOC)

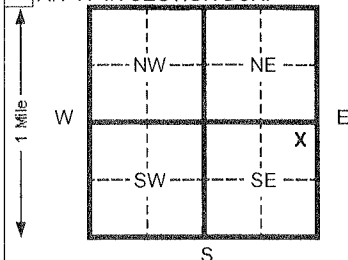

10/07/11

Was a chemical/bacteriological sample submitted to Department? Yes ☐ No ☒ If yes, mo/day/yr sample was

Was a chemical/bacteriological sample submitted to Department? Yes ☐ No ☒ If yes, mo/day/yr sample was submitted _____

Water Well Disinfected? Yes ☐ No ☒

CASING JOINTS: Glued Clamped

Welded

Threaded

Casing height above land surface	0	in., weight	0.703	lbs./ft. Wall thickness or gauge No.	SCH. 40
----------------------------------	---	-------------	-------	--------------------------------------	---------

10 Asbestos-cement

11 Other (specify)

12 None used (open hole)

11 None (open hole)

10 Other (specify)

	From	ft to	ft	From	ft to	ft
1.						
2.						
4 Other

Grout Intervals	From	1	ft.	to	9	ft.	From		ft.	to		ft.	From		ft.	to		ft.
-----------------	------	----------	-----	----	----------	-----	------	--	-----	----	--	-----	------	--	-----	----	--	-----

What is the nearest source of possible contamination:

14 Abandoned water well

16 Other (specify below)

13 Insecticide storage

Direction from well?

How many feet?

FROM	TO	CODE	LITHOLOGIC LOG	FROM	TO	PLUGGING INTERVALS
0	0.5		Gravel			
0.5	7.5		Fill, Clay, brown, sandy			
7.5	17		Sand, fine to medium grained, brown			
17	19		Interbedded Clay and Sand, dark brown			
19	25		Sand, with silt, coarse grained, orange brown			
						GPS (from SE corner of Section 17):
						Northing: 2284.62
						Easting: 77.19

This Water Well Record was completed on (mo/day/yr) **10/20/11**

by (signature)

INSTRUCTIONS: Please fill in blanks and circle the correct answers. Send three copies to Kansas Department of Health and Environment, Bureau of Water, 1000 S W Jackson St., Ste. 420, Topeka, Kansas 66612-1367. Telephone: 913-296-5545. Send one to WATER WELL OWNER and retain one for your records.