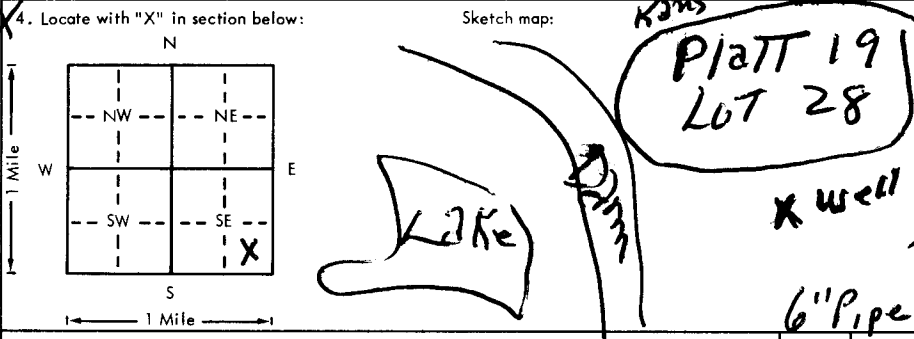


USE TYPEWRITER OR BALL
POINT PEN-PRESS FIRMLY,
PRINT CLEARLY.

WATER WELL RECORD
KSA 82a-1201-1215

Kansas Department of Health and
Environment-Division of Environment
(Water well Contractors)
Topeka, Kansas 66620

1. Location of well: Linn		2. Distance and direction from nearest town or city: Well Drilled at Sugar Valley Street address of well location if in city: 1 mile South Mound City		3. Owner of well: FL Failles R.R. or street: 5612 Nieman Rd City, state, zip code: Shawnee, Kans 66203		4. Locate with "X" in section below: 		5. Type and color of material		6. Bore hole dia. 8 1/4 in. Completion date 6/3/78 Well depth 50 ft.		7. <input checked="" type="checkbox"/> Cable tool <input type="checkbox"/> Rotary <input type="checkbox"/> Driven <input type="checkbox"/> Dug <input type="checkbox"/> Hollow rod <input type="checkbox"/> Jetted <input type="checkbox"/> Bored <input type="checkbox"/> Reverse rotary		8. Use: <input checked="" type="checkbox"/> Domestic <input type="checkbox"/> Public supply <input type="checkbox"/> Industry <input type="checkbox"/> Irrigation <input type="checkbox"/> Air conditioning <input type="checkbox"/> Stock <input type="checkbox"/> Lawn <input type="checkbox"/> Oil field water <input type="checkbox"/> Other		9. Casing: Material Iron Height: Above or below Threading Welded Surface 12 in. RMP PVC Weight 12 lbs./ft. Dia. 6 in. to 50 ft. depth Wall Thickness: inches or Dia. 6 in. to 50 ft. depth gage No.		10. Screen: Manufacturer's name Kerstream Type 100 Dia. 6 in. Slot/gauze 030 Length 8 in. Set between 20 ft. and 50 ft. Grovel pack? <input checked="" type="checkbox"/> Size range of material 1/2" to 3/4"		11. Static water level: 10 ft. below land surface Date 6/3/78		12. Pumping level below land surfaces: ____ ft. after ____ hrs. pumping ____ g.p.m. ____ ft. after ____ hrs. pumping ____ g.p.m. Estimated maximum yield ____ g.p.m.		13. Water samples submitted: ____ mo./day/yr. ____ Yes <input checked="" type="checkbox"/> No Date ____		14. Well head completion: ____ Pitless adapter ____ Inches above grade		15. Well grouted? Yes With: <input checked="" type="checkbox"/> Neat cement <input type="checkbox"/> Bentonite <input type="checkbox"/> Concrete Depth: From 0 ft. to 10 ft.		16. Nearest source of possible contamination: ft. 10 ft. Direction SE Type Crack Well disinfected upon completion? <input checked="" type="checkbox"/> Yes <input type="checkbox"/> No		17. Pump: <input checked="" type="checkbox"/> Not installed Manufacturer's name ____ Model number ____ HP ____ Volts ____ Length of drop pipe ____ ft. capacity ____ g.p.m. Type: ____ Submersible ____ Turbine ____ Jet ____ Reciprocating ____ Centrifugal ____ Other		18. Elevation: ____		19. Remarks: Topography: ____ Hill ____ Slope ____ Upland <input checked="" type="checkbox"/> Valley		20. Water well contractor's certification: This well was drilled under my jurisdiction and this report is true to the best of my knowledge and belief. Eureka Well Service 296 Business name License No. 225 SWALMT Eureka, Kans Address Shawnee, Kans Signed True Ashlock Date 6-3-78 Authorized representative	

Forward the white, blue and pink copies to the Department of Health and Environment

Form WWC-5