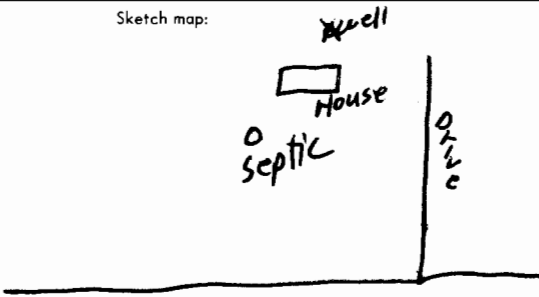


USE TYPEWRITER OR BALL
POINT PEN-PRESS FIRMLY,
PRINT CLEARLY.

WATER WELL RECORD
KSA 82a-1201-1215

Kansas Department of Health and
Environment-Division of Environment
(Water well Contractors)
Topeka, Kansas 66620

1. Location of well: County Linn		Fraction NE SW SE 1/4 1/4 1/4		Section number 20	Township number 22	Range number 25
2. Distance and direction from nearest town or city: 3 miles north of Prescott				3. Owner of well: Jim Shoemaker R.R. or street: 4301 Swartz City, state, zip code: Kansas City, Ks 66106		
4. Locate with "X" in section below: N W E S 1 Mile		Sketch map: 		6. Bore hole dia. 7 3/8 in. Completion date 5/11/79 Well depth 140 ft.		
5. Type and color of material		From To		7. Cable tool <input checked="" type="checkbox"/> Rotary <input type="checkbox"/> Driven <input type="checkbox"/> Dug <input type="checkbox"/> Hollow rod <input type="checkbox"/> Jetted <input type="checkbox"/> Bored <input type="checkbox"/> Reverse rotary		
surface		0 3		8. Use: <input checked="" type="checkbox"/> Domestic <input type="checkbox"/> Public supply <input type="checkbox"/> Industry <input type="checkbox"/> Irrigation <input type="checkbox"/> Air conditioning <input type="checkbox"/> Stock <input type="checkbox"/> Lawn <input type="checkbox"/> Oil field water <input type="checkbox"/> Other		
clay (yellow, sandy)		3 5		9. Casing: Material <input type="checkbox"/> Height: Above or below Threaded <input checked="" type="checkbox"/> Dry Hole Surface <input type="checkbox"/> in. RMP <input type="checkbox"/> PVC Weight <input type="checkbox"/> lbs./ft.		
shale (sandy, grey)		5 10		Dia. <input type="checkbox"/> in. to <input type="checkbox"/> ft. depth Wall Thickness: inches or Dia. <input type="checkbox"/> in. to <input type="checkbox"/> ft. depth gage No. <input type="checkbox"/>		
lime (grey)		10 13		10. Screen Manufacturer's name Dry Hole		
shale (green)		13 25		Type <input type="checkbox"/> Dia. <input type="checkbox"/> Slot/gouze <input type="checkbox"/> Length <input type="checkbox"/> Set between <input type="checkbox"/> ft. and <input type="checkbox"/> ft. <input type="checkbox"/> ft. and <input type="checkbox"/> ft.		
shale (red)		25 27		Gravel pack? <input type="checkbox"/> Size range of material <input type="checkbox"/>		
shale (grey)		27 45		11. Static water level Dry Hole ma./day/yr. <input type="checkbox"/> ft. below land surface Date <input type="checkbox"/>		
lime (grey)		45 50		12. Pumping level below land surfaces: <input type="checkbox"/> ft. after <input type="checkbox"/> hrs. pumping <input type="checkbox"/> g.p.m. <input type="checkbox"/> ft. after <input type="checkbox"/> hrs. pumping <input type="checkbox"/> g.p.m.		
shale (grey)		50 52		Estimated maximum yield <input type="checkbox"/> g.p.m.		
lime (grey)		52 53		13. Water sample submitted: Dry Hole mo./day/yr. <input type="checkbox"/> Yes <input checked="" type="checkbox"/> No Date <input type="checkbox"/>		
shale (grey)		53 108		14. Well head completion: <input type="checkbox"/> Pitless adapter <input type="checkbox"/> Inches above grade		
coal (black)		108 111		15. Well Dry Hole With: <input type="checkbox"/> Neat cement <input type="checkbox"/> Bentonite <input type="checkbox"/> Concrete Depth: From <input type="checkbox"/> ft. to <input type="checkbox"/> ft.		
shale (grey)		111 116		16. Nearest source of possible contamination: ft. <input type="checkbox"/> Direction <input type="checkbox"/> Type <input type="checkbox"/> Well disinfected upon completion? <input type="checkbox"/> Yes <input checked="" type="checkbox"/> No		
lime (brown)		116 120		17. Pump Dry Hole <input type="checkbox"/> Not installed Manufacturer's name <input type="checkbox"/> Model number <input type="checkbox"/> HP <input type="checkbox"/> Volts <input type="checkbox"/> Length of drop pipe <input type="checkbox"/> ft. capacity <input type="checkbox"/> g.p.m. Type: <input type="checkbox"/> Submersible <input type="checkbox"/> Turbine <input type="checkbox"/> Jet <input type="checkbox"/> Reciprocating <input type="checkbox"/> Centrifugal <input type="checkbox"/> Other		
18. Elevation: 900		19. Remarks: Customer is aware of state regulation to install a 4' square concrete platform around well.		20. Water well contractor's certification: This well was drilled under my jurisdiction and this report is true to the best of my knowledge and belief. F.E. Young Drilling Co., Inc. 240 Business name 6355 Robinhood Ln. License No. <input type="checkbox"/> Address <input type="checkbox"/> Signed David Young Date 6/19/79 Authorized representative		

Forward the white, blue and pink copies to the Department of Health and Environment

Farm WWC-5