


mw-2

WATER WELL RECORD Form WWC-5 KSA 82a-1212

1 LOCATION OF WATER WELL: County: Marion Fraction: NE 1/4 NE 1/4 NW 1/4 Section Number: 4 Township Number: T 22 S Range Number: R 3 EW

Distance and direction from nearest town or city street address of well if located within city? 911 N. Walnut, Peabody KS

2 WATER WELL OWNER: C-Mat #2524
RR#, St. Address, Box #: 110 S. Main, Suite 500
City, State, ZIP Code: Wichita, KS 67202-3745
Board of Agriculture, Division of Water Resources
Application Number:

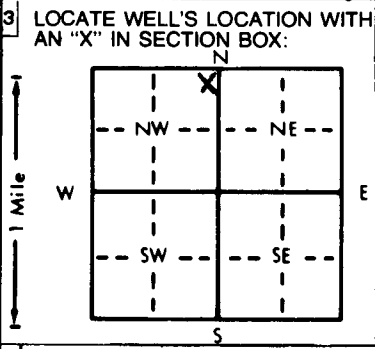

4 DEPTH OF COMPLETED WELL: 30' ft. ELEVATION: _____ ft.
Depth(s) Groundwater Encountered 1. ~24 ft. 2. _____ ft. 3. _____ ft.
WELL'S STATIC WATER LEVEL 20.81 ft. below land surface measured on mo/day/yr 4/15/99
Pump test data: Well water was _____ ft. after _____ hours pumping _____ gpm
Est. Yield _____ gpm: Well water was _____ ft. after _____ hours pumping _____ gpm
Bore Hole Diameter 8.625 in. to 30 ft., and _____ in. to _____ ft.
WELL WATER TO BE USED AS: 5 Public water supply 8 Air conditioning 11 Injection well
1 Domestic 3 Feedlot 6 Oil field water supply 9 Dewatering 12 Other (Specify below)
2 Irrigation 4 Industrial 7 Lawn and garden only 10 Monitoring well mw-2
Was a chemical/bacteriological sample submitted to Department? Yes _____ No X; If yes, mo/day/yr sample was submitted
Water Well Disinfected? Yes _____ No X

5 TYPE OF BLANK CASING USED: 1 Steel 3 RMP (SR) 5 Wrought iron 8 Concrete tile CASING JOINTS: Glued _____ Clamped _____
2 PVC 4 ABS 6 Asbestos-Cement 9 Other (specify below) Welded _____
Blank casing diameter 4" in. to 15 ft., Dia _____ in. to _____ ft., Dia _____ in. to _____ ft.
Casing height above land surface 0-Flush in., weight sch. 40 lbs./ft. Wall thickness or gauge No. _____
TYPE OF SCREEN OR PERFORATION MATERIAL: 1 Steel 3 Stainless steel 5 Fiberglass 8 RMP (SR) 10 Asbestos-cement
2 Brass 4 Galvanized steel 6 Concrete tile 9 ABS 11 Other (specify) _____
SCREEN OR PERFORATION OPENINGS ARE: 1 Continuous slot 3 Mill slot 5 Gauzed wrapped 8 Saw cut 11 None (open hole)
2 Louvered shutter 4 Key punched 6 Wire wrapped 9 Drilled holes
3 Screen-perforated intervals: From 15 ft. to 30 ft., From _____ ft. to _____ ft.
GRAVEL PACK INTERVALS: From 14 ft. to 30 ft., From _____ ft. to _____ ft.

6 GROUT MATERIAL: 1 Neat cement 2 Cement grout 3 Bentonite 4 Other _____
Grout Intervals: From 0 ft. to 12 ft., From 12 ft. to 14 ft., From _____ ft. to _____ ft.
What is the nearest source of possible contamination: 1 Septic tank 4 Lateral lines 7 Pit privy 10 Livestock pens 14 Abandoned water well
2 Sewer lines 5 Cess pool 8 Sewage lagoon 11 Fuel storage 15 Oil well/Gas well
3 Watertight sewer lines 6 Seepage pit 9 Feedyard 12 Fertilizer storage 16 Other (specify below) cont. site
13 Insecticide storage

FROM	TO	LITHOLOGIC LOG	FROM	TO	PLUGGING INTERVALS
0	1	Concrete			
1	3	Fill sand			
3	16	clay w/some silt			
16	26.5	silt w/some clay			
26.5	30	Gravel w/silt			
30	TD	End of borehole			

7 CONTRACTOR'S OR LANDOWNER'S CERTIFICATION: This water well was 1 constructed, 2 reconstructed, or 3 plugged under my jurisdiction and was completed on (mo/day/year) 4/5/99 and this record is true to the best of my knowledge and belief. Kansas Water Well Contractor's License No. 585 This Water Well Record was completed on (mo/day/yr) 4/8/99 under the business name of AET by (signature) [Signature]

INSTRUCTIONS: Use typewriter or ball point pen. PLEASE PRESS FIRMLY and PRINT clearly. Please fill in blanks, underline or circle the correct answers. Send top three copies to Kansas Department of Health and Environment, Bureau of Water, Topeka, Kansas 66620-0001. Telephone: 913-296-5545. Send one to WATER WELL OWNER and retain one for your records.

OFFICE USE ONLY
T
R
EW
SEC.