


WATER WELL RECORD Form WWC-5 KSA 82a-1212

1 LOCATION OF WATER WELL: County: Marion Fraction NE SW SE NW Section Number 33 4 Township Number T 22 S Range Number R 3 E/W

Distance and direction from nearest town or city street address of well if located within city? In city limits - 408 N. Olive St., Peabody, KS

2 WATER WELL OWNER: Randy Dallke RR#, St. Address, Box # : 408 N. Olive St. Board of Agriculture, Division of Water Resources City, State, ZIP Code : Peabody, KS 66866 Application Number:

3 LOCATE WELL'S LOCATION WITH AN "X" IN SECTION BOX: 4 DEPTH OF COMPLETED WELL... 50... ft. ELEVATION:

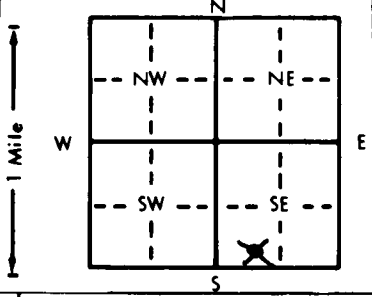

Depth(s) Groundwater Encountered 1. ... ft. 2. ... ft. 3. ... ft. WELL'S STATIC WATER LEVEL ... 1.1 ... ft. below land surface measured on mo/day/yr 7/7/99 Pump test data: Well water was ... ft. after ... hours pumping ... gpm Est. Yield 20-30 gpm: Well water was ... ft. after ... hours pumping ... gpm Bore Hole Diameter ... 9 ... in. to ... 52 ... ft. and ... in. to ... ft. WELL WATER TO BE USED AS: 5 Public water supply 8 Air conditioning 11 Injection well 1 Domestic 3 Feedlot 6 Oil field water supply 9 Dewatering 12 Other (Specify below) 2 Irrigation 4 Industrial 7 Lawn and garden only 10 Monitoring well ... Was a chemical/bacteriological sample submitted to Department? Yes ... No X ...; If yes, mo/day/yr sample was submitted Water Well Disinfected? Yes X No

5 TYPE OF BLANK CASING USED: 1 Steel 3 RMP (SR) 5 Wrought iron 8 Concrete tile CASING JOINTS: Glued X Clamped 2 PVC 4 ABS 6 Asbestos-Cement 9 Other (specify below) Welded Threaded

Blank casing diameter ... 5 ... in. to ... 40 ... ft., Dia ... in. to ... ft., Dia ... in. to ... ft. Casing height above land surface ... 12 ... in., weight ... 2.37 ... lbs./ft. Wall thickness or gauge No. ... 214

TYPE OF SCREEN OR PERFORATION MATERIAL: 1 Steel 3 Stainless steel 5 Fiberglass 8 RMP (SR) 10 Asbestos-cement 2 Brass 4 Galvanized steel 6 Concrete tile 9 ABS 11 Other (specify) 12 None used (open hole) X PVC

SCREEN OR PERFORATION OPENINGS ARE: 1 Continuous slot 3 Mill slot 5 Gauzed wrapped 8 Saw cut 11 None (open hole) 2 Louvered shutter 4 Key punched 6 Wire wrapped 9 Drilled holes 10 Other (specify) 7 Torch cut

SCREEN-PERFORATED INTERVALS: From ... 40 ... ft. to ... 50 ... ft., From ... ft. to ... ft. From ... ft. to ... ft. From ... ft. to ... ft. From ... ft. to ... ft.

GRAVEL PACK INTERVALS: From ... 20 ... ft. to ... 50 ... ft., From ... ft. to ... ft. From ... ft. to ... ft. From ... ft. to ... ft. From ... ft. to ... ft.

6 GROUT MATERIAL: 1 Neat cement 2 Cement grout 3 Bentonite 4 Other Grout Intervals: From ... 0 ... ft. to ... 20 ... ft., From ... ft. to ... ft., From ... ft. to ... ft.

What is the nearest source of possible contamination: None within 1/4 mile 10 Livestock pens 14 Abandoned water well 1 Septic tank 4 Lateral lines 7 Pit privy 11 Fuel storage 15 Oil well/Gas well 2 Sewer lines 5 Cess pool 8 Sewage lagoon 12 Fertilizer storage 16 Other (specify below) 3 Watertight sewer lines 6 Seepage pit 9 Feedyard 13 Insecticide storage

Direction from well? How many feet?

Table with 4 columns: FROM, TO, LITHOLOGIC LOG, FROM, TO, PLUGGING INTERVALS. Rows include: 0-2 Topsoil, 2-12 Brown Clay, 12-41 Blue Shale & Limestone, 41-50 Fractured Limestone, 50-52 Shale.

7 CONTRACTOR'S OR LANDOWNER'S CERTIFICATION: This water well was X constructed, (2) reconstructed, or (3) plugged under my jurisdiction and was completed on (mo/day/year) 7/7/99 and this record is true to the best of my knowledge and belief. Kansas Water Well Contractor's License No. 138 This Water Well Record was completed on (mo/day/yr) 7/20/99 under the business name of PETERSON IRRIGATION, INC. by (signature) Mike Peters