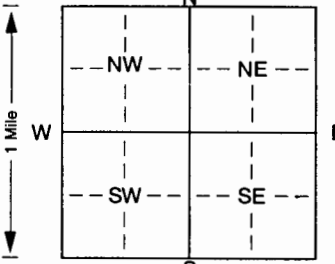


1 LOCATION OF WATER WELL: Fraction NW 1/4 SW 1/4 SE 1/4 Section Number 4 Township Number T 22 S Range Number R 3 W
 County: Marion Distance and direction from nearest town or city street address of well if located within city? 201 S. Maple Peabody, Ks MW#4

2 WATER WELL OWNER: Farmers Coop Board of Agriculture, Division of Water Resources
 RR#, St. Address, Box #: 201 S Maple Peabody Ks Application Number:
 City, State, ZIP Code:

3 LOCATE WELL'S LOCATION WITH AN "X" IN SECTION BOX:

 4 DEPTH OF COMPLETED WELL: 30 ft. ELEVATION:
 Depth(s) Groundwater Encountered 1. ft. 2. ft. 3. ft.
 WELL'S STATIC WATER LEVEL ft. below land surface measured on mo/day/yr
 Pump test data: Well water was ft. after hours pumping gpm
 Est. Yield gpm: Well water was ft. after hours pumping gpm
 Bore Hole Diameter: 7 1/4 in. to 30 ft., and in. to ft.
 WELL WATER TO BE USED AS: 5 Public water supply 8 Air conditioning 11 Injection well
 1 Domestic 3 Feedlot 6 Oil field water supply 9 Dewatering 12 Other (Specify below)
 2 Irrigation 4 Industrial 7 Domestic (lawn & garden) Monitoring well
 Was a chemical/bacteriological sample submitted to Department? Yes. No. ; If yes, mo/day/yrs sample was submitted Water Well Disinfected? Yes No

5 TYPE OF BLANK CASING USED: 5 Wrought iron 8 Concrete tile CASING JOINTS: Glued. Clamped.
 1 Steel 3 RMP (SR) 6 Asbestos-Cement 9 Other (specify below) Welded
 PVC 4 ABS 7 Fiberglass Threaded.
 Blank casing diameter in. to ft., Dia in. to ft., Dia in. to ft.
 Casing height above land surface. in., weight Sched 40 lbs./ft. Wall thickness or gauge No.
 TYPE OF SCREEN OR PERFORATION MATERIAL: PVC 10 Asbestos-cement
 1 Steel 3 Stainless steel 5 Fiberglass 8 RMP (SR) 11 Other (specify)
 2 Brass 4 Galvanized steel 6 Concrete tile 9 ABS 12 None used (open hole)
 SCREEN OR PERFORATION OPENINGS ARE: 5 Gauzed wrapped 8 Saw cut 11 None (open hole)
 1 Continuous slot Mill slot 0.10 6 Wire wrapped 9 Drilled holes
 2 Louvered shutter 4 Key punched 7 Torch cut 10 Other (specify) ft.
 SCREEN-PERFORATED INTERVALS: From 30 ft. to 10 ft., From ft. to ft.
 From ft. to ft., From ft. to ft.
 GRAVEL PACK INTERVALS: From 30 ft. to 8 ft., From ft. to ft.
 From ft. to ft., From ft. to ft.

6 GROUT MATERIAL: 1 Neat cement Cement grout Bentonite 4 Other
 Grout Intervals: From 3 ft. to 3 ft., From 8 ft. to 3 ft., From ft. to ft.
 What is the nearest source of possible contamination:
 1 Septic tank 4 Lateral lines 7 Pit privy Fuel storage 10 Livestock pens 14 Abandoned water well
 2 Sewer lines 5 Cess pool 8 Sewage lagoon 12 Fertilizer storage 15 Oil well/Gas well
 3 Watertight sewer lines 6 Seepage pit 9 Feedyard 13 Insecticide storage 16 Other (specify below)
 Direction from well? East How many feet? 80'

FROM	TO	LITHOLOGIC LOG	FROM	TO	PLUGGING INTERVALS
0	2	topsoil grass & fill clay			
2	10	fin silty clay			
10	18	med silty clay w traces sand FG			
18	23	clayey sand wlt @ 21			
21	30	silty clayey bit tan sand			

7 CONTRACTOR'S OR LANDOWNER'S CERTIFICATION: This water well was constructed, (2) reconstructed, or (3) plugged under my jurisdiction and was completed on (mo/day/year) 01-10-01 and this record is true to the best of my knowledge and belief. Kansas Water Well Contractor's Licence No. 575 This Water Well Record was completed on (mo/day/yr) 0-1-28-9 under the business name of FUNKIE DRILLING SERVICE by (signature) [Signature]