


(Copy)

1 LOCATION OF WATER WELL: Fraction ~~SW~~ ^{NE} 1/4 NE 1/4 NE 1/4 Section Number 4 Township Number T 22 S Range Number R 3 E/W

Distance and direction from nearest town or city street address of well if located within city? "Steam Plant Well"

2 WATER WELL OWNER: City of Reebody, KS RR#, St. Address, Box #: Reebody Kansas 66866 Board of Agriculture, Division of Water Resources Application Number: X

3 LOCATE WELL'S LOCATION WITH AN "X" IN SECTION BOX: 4 DEPTH OF COMPLETED WELL: 60 ft. ELEVATION: Depth(s) Groundwater Encountered 1. 23 ft. 2. 52 ft. 3. WELL'S STATIC WATER LEVEL: 14 ft. below land surface measured on mo/day/yr Completion

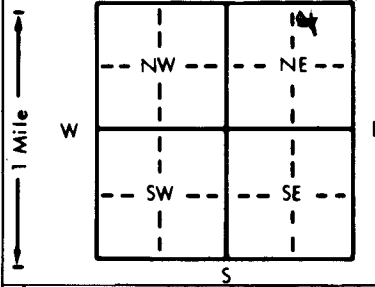

Pump test data: Well water was ... ft. after ... hours pumping ... gpm Est. Yield 100 gpm: Well water was ... ft. after ... hours pumping ... gpm Bore Hole Diameter: 14 in. to 60 ft., and ... in. to ... ft. WELL WATER TO BE USED AS: 5 Public water supply 8 Air conditioning 11 Injection well 1 Domestic 3 Feedlot 6 Oil field water supply 9 Dewatering 12 Other (Specify below) 2 Irrigation 4 Industrial 7 Lawn and garden only 10 Observation well none Was a chemical/bacteriological sample submitted to Department? Yes X No; If yes, mo/day/yr sample was submitted ? Water Well Disinfected? Yes X No

5 TYPE OF BLANK CASING USED: 1 Steel 3 RMP (SR) 5 Wrought iron 8 Concrete tile CASING JOINTS: Glued Clamped 2 PVC 4 ABS 6 Asbestos-Cement 9 Other (specify below) Welded 7 Fiberglass Threaded

Blank casing diameter: 8 in. to bottom ft., Dia. Casing height above land surface: 3 1/2 ft., weight lbs./ft. Wall thickness or gauge No. 338

TYPE OF SCREEN OR PERFORATION MATERIAL: 1 Steel 3 Stainless steel 5 Fiberglass 8 RMP (SR) 11 Other (specify) 2 Brass 4 Galvanized steel 6 Concrete tile 9 ABS 12 None used (open hole)

SCREEN OR PERFORATION OPENINGS ARE: 1 Continuous slot 3 Mill slot 5 Gauzed wrapped 8 Saw cut 11 None (open hole) 2 Louvered shutter 4 Key punched 6 Wire wrapped 9 Drilled holes 7 Torch cut 10 Other (specify)

SCREEN-PERFORATED INTERVALS: From 23 ft. to 53 ft. GRAVEL PACK INTERVALS: From none ft. to ... ft.

6 GROUT MATERIAL: 1 Neat cement 2 Cement grout 3 Bentonite 4 Other Grout intervals: From 0 ft. to 20 ft.

What is the nearest source of possible contamination: 1 Septic tank 4 Lateral lines 7 Pit privy 10 Livestock pens 14 Abandoned water well 2 Sewer lines 5 Cess pool 8 Sewage lagoon 11 Fuel storage 15 Oil well/Gas well 3 Watertight sewer lines 6 Seepage pit 9 Feedyard 12 Fertilizer storage 16 Other (specify below) 13 Insecticide storage none

Direction from well? How many feet?

FROM	TO	LITHOLOGIC LOG	FROM	TO	LITHOLOGIC LOG
1	4	soil			
4	7	brown clay			
7	220	yellow clay			
22	252	limestone some water			
25	43	blue to black shale			
43	479	dark hard shale			
47	520	limestone			
52	607	Casing shale			

7 CONTRACTOR'S OR LANDOWNER'S CERTIFICATION: This water well was (1) constructed, (2) reconstructed, or (3) plugged under my jurisdiction and was completed on (mo/day/year) May 6-81 and this record is true to the best of my knowledge and belief. Kansas Water Well Contractor's License No. 396 This Water Well Record was completed on (mo/day/yr) May 7-81 under the business name of Oursler Bros Const by (signature) Kermit Oursler

INSTRUCTIONS: Use typewriter or ball point pen, PLEASE PRESS FIRMLY and PRINT clearly. Please fill in blanks, underline or circle the correct answers. Send top three copies to Kansas Department of Health and Environment, Division of Environment, Environmental Geology Section, Topeka, KS 66620. Send one to WATER WELL OWNER and retain one for your records.