


(Copy)

1 LOCATION OF WATER WELL: **Section** 34W 1/4 SE 1/4 NW 1/4 Section Number 22 Township Number T 22 S Range Number R 3 E/W
 County: Marion
 Distance and direction from nearest town or city street address of well if located within city? Plum St Well (rework or cleanout)

2 WATER WELL OWNER: City of Peabody Kansas Board of Agriculture, Division of Water Resources
 RR#, St. Address, Box #: 66866 Application Number: 22
 City, State, ZIP Code: 66866

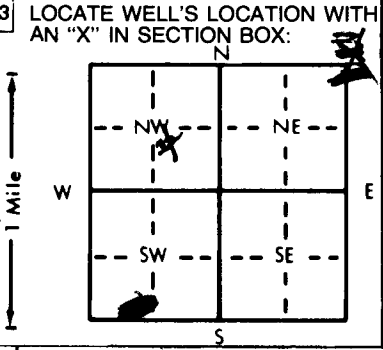

 WELL WATER TO BE USED AS: 5 Public water supply 8 Air conditioning 11 Injection well
 1 Domestic 3 Feedlot 6 Oil field water supply 9 Dewatering 12 Other (Specify below)
 2 Irrigation 4 Industrial 7 Lawn and garden only 10 Observation well
 Was a chemical/bacteriological sample submitted to Department? Yes X No ; If yes, mo/day/yr sample was submitted
 Water Well Disinfected? Yes X No

5 TYPE OF BLANK CASING USED: 1 Steel 3 RMP (SR) 5 Wrought iron 8 Concrete tile CASING JOINTS: Glued X Clamped
2 PVC 4 ABS 6 Asbestos-Cement 9 Other (specify below) Welded
 7 Fiberglass Threaded
 TYPE OF SCREEN OR PERFORATION MATERIAL: PVC 10 Asbestos-cement
 1 Steel 3 Stainless steel 5 Fiberglass 8 RMP (SR) 11 Other (specify)
 2 Brass 4 Galvanized steel 6 Concrete tile 9 ABS 12 None used (open hole)
 SCREEN OR PERFORATION OPENINGS ARE: 5 Gauzed wrapped 8 Saw cut 11 None (open hole)
 1 Continuous slot 3 Mill slot 6 Wire wrapped 9 Drilled holes
 2 Louvered shutter 4 Key punched 7 Torch cut 10 Other (specify)

 What is the nearest source of possible contamination:
 1 Septic tank 4 Lateral lines 7 Pit privy 10 Livestock pens 14 Abandoned water well
 2 Sewer lines 5 Cess pool 8 Sewage lagoon 11 Fuel storage 15 Oil well/Gas well
 3 Watertight sewer lines 6 Seepage pit 9 Feedyard 12 Fertilizer storage 16 Other (specify below) None
 13 Insecticide storage None
 Direction from well? How many feet?

FROM	TO	LITHOLOGIC LOG	FROM	TO	LITHOLOGIC LOG
		<u>Engineers turned log on this job</u>			
		<u>Need Copy!</u>			
<u>1</u>	<u>5</u>	<u>black soil</u>			
<u>5</u>	<u>11</u>	<u>0 (brown clay</u>			
<u>11</u>	<u>19</u>	<u>tan</u>			
<u>19</u>	<u>31</u>	<u>black shale</u>			
<u>32</u>	<u>34</u>	<u>hard black shale (water)</u>			
<u>34</u>	<u>51</u>	<u>dark blue shale</u>			
<u>51</u>	<u>60</u>	<u>blue shale</u>			

7 CONTRACTOR'S OR LANDOWNER'S CERTIFICATION: This water well was (1) constructed, (2) reconstructed, or (3) plugged under my jurisdiction and was completed on (mo/day/year) May 2 - 81 and this record is true to the best of my knowledge and belief. Kansas Water Well Contractor's License No. 396 This Water Well Record was completed on (mo/day/yr) under the business name of Cursler Briscoat by (signature) Hermit Cursler
 INSTRUCTIONS: Use typewriter or ball point pen, PLEASE PRESS FIRMLY and PRINT clearly. Please fill in blanks, underline or circle the correct answers. Send top three copies to Kansas Department of Health and Environment, Division of Environment, Environmental Geology Section, Topeka, KS 66620. Send one to WATER WELL OWNER and retain one for your records.