


1 LOCATION OF WATER WELL: County: **MARION** Fraction: **NE 1/4 NE 1/4 NE 1/4** Section Number: **4** Township Number: **T 22 S** Range Number: **R 3 EW**

Distance and direction from nearest town or city street address of well if located within city?
NE-C-CITY OF MARION PEABODY

2 WATER WELL OWNER: **KANSAS DEPARTMENT OF TRANSFORMATION**
 RR#, St. Address, Box #: **DISTRICT TWO-AREA THREE-PO BOX 236**
 City, State, ZIP Code: **N. CEDAR ST. ATUS-56 - MARION, KS 66861-0236**
 Board of Agriculture, Division of Water Resources
 Application Number:

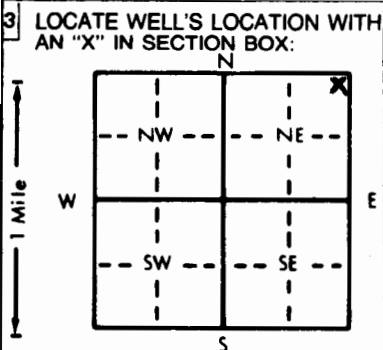

4 DEPTH OF COMPLETED WELL: **54** ft. ELEVATION: **-**
 Depth(s) Groundwater Encountered: 1. **UNKNOWN** ft. 2. **-** ft. 3. **-** ft.
 WELL'S STATIC WATER LEVEL: **27** ft. below land surface measured on mo/day/yr **04-22-94**
 Pump test data: Well water was **-** ft. after **-** hours pumping **-** gpm
 Est. Yield **-** gpm: Well water was **-** ft. after **-** hours pumping **-** gpm
 Bore Hole Diameter: **UNKNOWN** in. to **-** in. and **-** in. to **-** in.
 WELL WATER TO BE USED AS:
 1 Domestic 3 Feedlot 6 Oil field water supply 9 Dewatering
 2 Irrigation 4 Industrial 7 Lawn and garden only 10 Monitoring well
 Was a chemical/bacteriological sample submitted to Department? Yes No If yes, mo/day/yr sample was submitted **-**
 Water Well Disinfected? Yes No

5 TYPE OF BLANK CASING USED:
 1 Steel 3 RMP (SR) 5 Wrought iron 8 Concrete tile CASING JOINTS: Glued Clamped
 2 PVC 4 ABS 6 Asbestos-Cement 9 Other (specify below) Welded
 7 Fiberglass Threaded
 Blank casing diameter: **5** in. to **UNKNOWN** ft. Dia **-** in. to **-** ft. Dia **-** in. to **-** ft.
 Casing height above land surface: **48** in., weight **SLH 40** lbs./ft. Wall thickness or gauge No. **-**
 TYPE OF SCREEN OR PERFORATION MATERIAL:
 1 Steel 3 Stainless steel 5 Fiberglass 7 PVC 10 Asbestos-cement
 2 Brass 4 Galvanized steel 6 Concrete tile 8 RMP (SR) 11 Other (specify)
 9 ABS 12 None used (open hole)
 SCREEN OR PERFORATION OPENINGS ARE:
 1 Continuous slot 3 Mill slot 5 Gauzed wrapped 8 Saw cut 11 None (open hole)
 2 Louvered shutter 4 Key punched 6 Wire wrapped 9 Drilled holes
 7 Torch cut 10 Other (specify) **UNKNOWN**
 SCREEN-PERFORATED INTERVALS: From **UNKNOWN** ft. to **-** ft. From **-** ft. to **-** ft.
SAID From **-** ft. to **-** ft. From **-** ft. to **-** ft.
~~GRAVEL~~ PACK INTERVALS: From **24** ft. to **54** ft. From **-** ft. to **-** ft.

6 GROUT MATERIAL: 1 Neat cement 2 Cement grout 3 Bentonite 4 Other
 Grout Intervals: From **4** ft. to **24** ft. From **-** ft. to **-** ft. From **-** ft. to **-** ft.
 What is the nearest source of possible contamination:
 1 Septic tank 4 Lateral lines 7 Pit privy 10 Livestock pens 14 Abandoned water well
 2 Sewer lines 5 Cess pool 8 Sewage lagoon 11 Fuel storage 15 Oil well/Gas well
 3 Watertight sewer lines 6 Seepage pit 9 Feedyard 12 Fertilizer storage 16 Other (specify below) **NA**
 13 Insecticide storage
 Direction from well? **-** How many feet? **-**

FROM	TO	LITHOLOGIC LOG	FROM	TO	PLUGGING INTERVALS
		NO RECORDS FOUND			
		5' SQ - 5' DEEP PIT - REMOVED - BACK FILLED			

7 CONTRACTOR'S OR LANDOWNER'S CERTIFICATION: This water well was (1) constructed, (2) reconstructed, or (3) plugged under my jurisdiction and was completed on (mo/day/year) **04-22-94** and this record is true to the best of my knowledge and belief. Kansas Water Well Contractor's License No. **479** This Water Well Record was completed on (mo/day/yr) **05-16-94** under the business name of **EBBERTS DRILLING** by (signature) *Angela Ebberts*