


1 LOCATION OF WATER WELL: County: Marion Fraction: SW 1/4 NE 1/4 NE 1/4 Section-Number: 9 Township Number: T 22 S Range Number: R 3 E

Distance and direction from nearest town or city street address of well if located within city?
411 E. 6th St. Peabody, Kans.

2 WATER WELL OWNER: Clarence Tippin
 RR#, St. Address, Box #: 411 E. 6th St.
 City, State, ZIP Code: Peabody, Kansas 66866
 Board of Agriculture, Division of Water Resources
 Application Number:

3 LOCATE WELL'S LOCATION WITH AN "X" IN SECTION BOX:

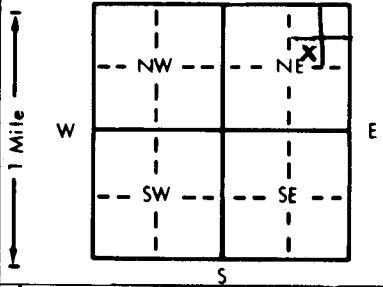

4 DEPTH OF COMPLETED WELL: 50 ft. ELEVATION:
 Depth(s) Groundwater Encountered 1 36 ft. 2 ft. 3 ft.
 WELL'S STATIC WATER LEVEL 15.5 ft. below land surface measured on mo/day/yr 5-9-84
 Pump test data: Well water was 41 ft. after 14 hours pumping 24 gpm
 Est. Yield 20-25 gpm: Well water was ft. after hours pumping gpm
 Bore Hole Diameter 8 in. to 10 ft., and 6 1/2 in. to 50 ft.
 WELL WATER TO BE USED AS:
 Domestic 3 Feedlot 6 Oil field water supply 9 Dewatering 12 Other (Specify below)
 2 Irrigation 4 Industrial 7 Lawn and garden only 10 Observation well
 Was a chemical/bacteriological sample submitted to Department? Yes..... No ; If yes, mo/day/yr sample was submitted
 Water Well Disinfected? Yes No

5 TYPE OF BLANK CASING USED:
 1 Steel 3 RMP (SR) 5 Wrought iron 8 Concrete tile CASING JOINTS: Glued Clamped
 2 PVC 4 ABS 6 Asbestos-Cement 9 Other (specify below) Welded
 7 Fiberglass Threaded
 Blank casing diameter 5 in. to 30 ft., Dia in. to ft., Dia in. to ft.
 Casing height above land surface 16 in., weight 216.603 lbs./ft. Wall thickness or gauge No. 15/64

TYPE OF SCREEN OR PERFORATION MATERIAL:
 1 Steel 3 Stainless steel 5 Fiberglass 8 RMP (SR) 10 Asbestos-cement
 2 Brass 4 Galvanized steel 6 Concrete tile 9 ABS 11 Other (specify)
 7 PVC 12 None used (open hole)

SCREEN OR PERFORATION OPENINGS ARE:
 1 Continuous slot 3 Mill slot 5 Gauzed wrapped 8 Saw cut 11 None (open hole)
 2 Louvered shutter 4 Key punched 6 Wire wrapped 9 Drilled holes
 7 Torch cut 10 Other (specify)

SCREEN-PERFORATED INTERVALS: From 30 ft. to 50 ft., From ft. to ft.
 From ft. to ft., From ft. to ft.
 GRAVEL PACK INTERVALS: From 15 ft. to 50 ft., From ft. to ft.
 From ft. to ft., From ft. to ft.

6 GROUT MATERIAL: 1 Neat cement 2 Cement grout 3 Bentonite 4 Other
 Grout Intervals: From 0 ft. to 12 ft., From ft. to ft., From ft. to ft.
 What is the nearest source of possible contamination:
 1 Septic tank 4 Lateral lines 7 Pit privy 10 Livestock pens 14 Abandoned water well
 2 Sewer lines 5 Cess pool 8 Sewage lagoon 11 Fuel storage 15 Oil well/Gas well
 3 Watertight sewer lines 6 Seepage pit 9 Feedyard 12 Fertilizer storage 16 Other (specify below)
 13 Insecticide storage
 Direction from well? W. How many feet? 40

FROM	TO	LITHOLOGIC LOG	FROM	TO	LITHOLOGIC LOG
0	5	Sandy Clay - Brown			
5	16	Clay - Brown			
16	18	Layer-Limestone Rock - Soft			
18	24	Clay - Blue-Gray			
24	35	Shale - Med Blue			
35	41	Water Gravel - Gray-White			
41	50	Shale - Med. Blue			

7 CONTRACTOR'S OR LANDOWNER'S CERTIFICATION: This water well was (1) constructed, (2) reconstructed, or (3) plugged under my jurisdiction and was completed on (mo/day/year) 5-9-84 and this record is true to the best of my knowledge and belief. Kansas Water Well Contractor's License No. 161 This Water Well Record was completed on (mo/day/yr) 5-31-84 under the business name of Benda Drilling by (signature) Paul W. Benda
 INSTRUCTIONS: Use typewriter or ball point pen, PLEASE PRESS FIRMLY and PRINT clearly. Please fill in blanks, underline or circle the correct answers. Send top three copies to Kansas Department of Health and Environment, Division of Environment, Environmental Geology Section, Topeka, KS 66620. Send one to WATER WELL OWNER and retain one for your records.