

WATER WELL RECORD Form WWC-5

Original Record Correction Change in Well Use

Division of Water Resources App. No.


[]

[] Well ID

1 LOCATION OF WATER WELL: County: Fraction 1/4 1/4 1/4 1/4 Section Number Township Number T S Range Number R E W

2 WELL OWNER: Last Name: First: Street or Rural Address where well is located (if unknown, distance and direction from nearest town or intersection): If at owner's address, check here: Business: Address: City: State: ZIP:

3 LOCATE WELL WITH "X" IN SECTION BOX: N

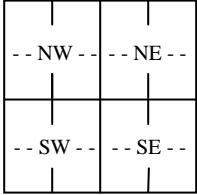

4 DEPTH OF COMPLETED WELL: Depth(s) Groundwater Encountered: 1) ft. 2) ft. 3) ft., or 4) Dry Well WELL'S STATIC WATER LEVEL: ft. below land surface, measured on (mo-day-yr) above land surface, measured on (mo-day-yr) Pump test data: Well water was ft. after hours pumping gpm Well water was ft. after hours pumping gpm Estimated Yield: gpm Bore Hole Diameter: in. to ft. and in. to ft.

5 Latitude: (decimal degrees) Longitude: (decimal degrees) Datum: WGS 84 NAD 83 NAD 27 Source for Latitude/Longitude: GPS (unit make/model: (WAAS enabled? Yes No) Land Survey Topographic Map Online Mapper:

6 Elevation: ft. Ground Level TOC Source: Land Survey GPS Topographic Map Other

7 WELL WATER TO BE USED AS: 1. Domestic: Household Lawn & Garden Livestock Irrigation Feedlot Industrial 5. Public Water Supply: well ID 6. Dewatering: how many wells? 7. Aquifer Recharge: well ID 8. Monitoring: well ID 9. Environmental Remediation: well ID Air Sparge Soil Vapor Extraction Recovery Injection 10. Oil Field Water Supply: lease 11. Test Hole: well ID Cased Uncased Geotechnical 12. Geothermal: how many bores? a) Closed Loop Horizontal Vertical b) Open Loop Surface Discharge Inj. of Water 13. Other (specify):

Was a chemical/bacteriological sample submitted to KDHE? Yes No If yes, date sample was submitted: Water well disinfected? Yes No

8 TYPE OF CASING USED: Steel PVC Other CASING JOINTS: Glued Clamped Welded Threaded Casing diameter in. to ft., Diameter in. to ft., Diameter in. to ft. Casing height above land surface in. Weight lbs./ft. Wall thickness or gauge No. TYPE OF SCREEN OR PERFORATION MATERIAL: Steel Stainless Steel Fiberglass PVC Other (Specify) Brass Galvanized Steel Concrete tile None used (open hole) SCREEN OR PERFORATION OPENINGS ARE: Continuous Slot Mill Slot Gauze Wrapped Torch Cut Drilled Holes Other (Specify) Louvered Shutter Key Punched Wire Wrapped Saw Cut None (Open Hole) SCREEN-PERFORATED INTERVALS: From ft. to ft., From ft. to ft., From ft. to ft. GRAVEL PACK INTERVALS: From ft. to ft., From ft. to ft., From ft. to ft.

9 GROUT MATERIAL: Neat cement Cement grout Bentonite Other Grout Intervals: From ft. to ft., From ft. to ft., From ft. to ft.

Nearest source of possible contamination: Septic Tank Lateral Lines Pit Privy Livestock Pens Insecticide Storage Sewer Lines Cess Pool Sewage Lagoon Fuel Storage Abandoned Water Well Watertight Sewer Lines Seepage Pit Feedyard Fertilizer Storage Oil Well/Gas Well Other (Specify) Direction from well? Distance from well? ft.

Table with 6 columns: 10 FROM, TO, LITHOLOGIC LOG, FROM, TO, LITHO. LOG (cont.) or PLUGGING INTERVALS. Includes a Notes section.

11 CONTRACTOR'S OR LANDOWNER'S CERTIFICATION: This water well was constructed, reconstructed, or plugged under my jurisdiction and was completed on (mo-day-year) and this record is true to the best of my knowledge and belief. Kansas Water Well Contractor's License No. This Water Well Record was completed on (mo-day-year) under the business name of

18843 Aug 30 2018

FULL SITE SURVEY


COASTAL MART #2524
PEABODY, KANSAS

Point	North Coordinate	East Coordinate	SE Cor. Sec. 04 North West	Distance From SE Cor. Sec. 04 North West	* Elev. Top of Rim or PK Nail	Elev. Top of PVC Pipe	Latitude North	Longitude West
SE Cor. Sec. 4-1225-R3E	5000	5000						
MW1	10278.89	2400.06	5278.89	2599.94	1389.39	1389.14	38.17435	97.10690
MW2	10291.25	2330.48	5291.25	2669.52	1391.00	1390.57	38.17439	97.10714
MW3	10245.03	2415.96	5245.03	2584.04	1388.75	1388.37	38.17426	97.10685
MW4	10328.05	2297.28	5328.05	2742.72	1390.31	1390.01	38.17449	97.10740
MW5	10244.35	2352.42	5244.35	2647.58	1389.94	1389.20	38.17426	97.10767
MW6	10293.10	2459.47	5293.10	2640.53	1389.92	1389.38	38.17439	97.10669
MW7	10156.51	2418.94	5156.51	2581.06	1387.88	1387.52	38.17402	97.10684
MW8	10205.61	2454.52	5205.61	2545.48	1388.73	1388.40	38.17415	97.10671
MW9	10006.69	2265.76	5006.69	2734.24	1385.74	1385.19	38.17361	97.10737
MW10	10017.74	2418.14	5017.74	2581.86	1386.07	1385.77	38.17364	97.10684
MW11	10020.84	2807.77	5020.84	2192.23	1392.55	1392.13	38.17364	97.10549
MW12	10288.27	2297.37	5288.27	2702.63	1390.93	1390.32	38.17452	97.10713
MW13	10278.39	2370.53	5278.39	2629.47	1389.62	1389.26	38.17449	97.10688
MW14	10250.93	2334.98	5250.93	2665.02	1389.74	1389.26	38.17442	97.10700
MW15	10263.50	2307.46	5263.50	2692.54	1390.42	1390.17	38.17445	97.10710
AS1	10294.22	2341.28	5294.22	2658.72	1389.73	1389.24	38.17443	97.10698
AS2	10241.64	2326.52	5241.64	2673.48	1389.89	1389.42	38.17439	97.10703
Site BM	10219.08	2290.33	5219.08	2709.67	B.M. Elev. = 1391.56			

Description: "□" Square cut top curb 4' east of NE corner of Coastal Mart building corner

LEGEND

- MW1 ⊕ MONITORING WELL LOCATION
- ⊕ SITE BENCHMARK
- EXIST W
- WATER LINE
- DRAINAGE DIRECTION
- OE
- OVERHEAD ELECTRIC
- E/E EDGE OF ROAD TO EDGE OF ROAD
- EXIST SS
- SANITARY SEWER
- B/B BACK TO BACK OF CURB
- ⊕ SIGN
- ⊕ POWER POLE
- ⊕ PP WITH TRANSFORMER
- ↓ DEADMAN ANCHOR
- ⊕ WM WATER METER
- ⊕ SANITARY SEWER MANHOLE

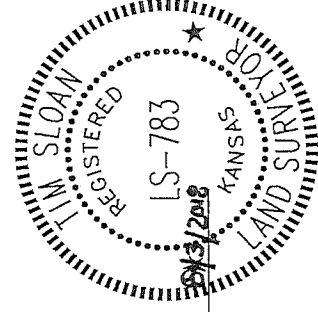

SMH Consultants
By: Tim Sloan
Tim Sloan
Tim Sloan, P.S.
President

FIGURE 1.3



2017 Vonesto Place, Suite 110 • Manhattan, Kansas 66503
(785) 776-0541 • FAX 776-9760 • Email: tim@smhconsultants.com
Drawn By: TMC Project #1806MN1173 DD #

