

**WATER WELL RECORD Form WWC-5**

Original Record  Correction  Change in Well Use

Division of Water Resources App. No.  

Well ID

MW10

<b>1 LOCATION OF WATER WELL:</b> County: <b>MARION</b>	Fraction NE ¼ NE ¼ NE ¼ SW ¼	Section Number <b>4</b>	Township Number <b>T 22 S</b>	Range Number <b>R 3 E W</b>
---	---------------------------------	----------------------------	----------------------------------	--------------------------------

<b>2 WELL OWNER:</b> Last Name: <b>First:</b> Business: <b>KDHE BER</b> Address: <b>1000 SW JACKSON</b> Address: City: <b>TOPEKA</b> State: <b>KS</b> ZIP: <b>66612-1367</b>	Street or Rural Address where well is located (if unknown, distance and direction from nearest town or intersection): If at owner's address, check here: <input checked="" type="checkbox"/> <b>215 N. Walnut St.</b> <b>Peabody, KS</b>
--	--

**3 LOCATE WELL WITH "X" IN SECTION BOX:**

N

NW	NE
SW	SE

S

-----1 mile-----

**4 DEPTH OF COMPLETED WELL:** ..... **20** ..... ft.

Depth(s) Groundwater Encountered: 1) ..... **15** ..... ft.

2) ..... ft. 3) ..... ft., or 4)  Dry Well

WELL'S STATIC WATER LEVEL: ..... **12.22** ..... ft.

below land surface, measured on (mo-day-yr) ..... **4/3/19** .....

above land surface, measured on (mo-day-yr) .....

Pump test data: Well water was ..... ft.

after ..... hours pumping ..... gpm

Well water was ..... ft.

after ..... hours pumping ..... gpm

Estimated Yield: ..... gpm

Bore Hole Diameter: ..... **8.5** ..... in. to ..... **20** ..... ft. and

..... in. to ..... ft.

**5 Latitude:** ..... **38.16672** ..... (decimal degrees)

**Longitude:** ..... **97.10744** ..... (decimal degrees)

Horizontal Datum:  WGS 84  NAD 83  NAD 27

Source for Latitude/Longitude:

GPS (unit make/model: .....)

(WAAS enabled?  Yes  No)

Land Survey  Topographic Map

Online Mapper: .....

---

**6 Elevation:** **1363.29** ..... ft.  Ground Level  TOC

Source:  Land Survey  GPS  Topographic Map

Other .....

**7 WELL WATER TO BE USED AS:**

1. Domestic: <input type="checkbox"/> Household <input type="checkbox"/> Lawn & Garden <input type="checkbox"/> Livestock 2. <input type="checkbox"/> Irrigation 3. <input type="checkbox"/> Feedlot 4. <input type="checkbox"/> Industrial	5. <input type="checkbox"/> Public Water Supply: well ID .....	10. <input type="checkbox"/> Oil Field Water Supply: lease .....
6. <input type="checkbox"/> Dewatering: how many wells? .....	7. <input type="checkbox"/> Aquifer Recharge: well ID .....	11. Test Hole: well ID .....
8. <input checked="" type="checkbox"/> Monitoring: well ID ..... <b>MW10</b> .....	9. Environmental Remediation: well ID .....	12. Geothermal: how many bores? .....
<input type="checkbox"/> Air Sparge <input type="checkbox"/> Soil Vapor Extraction <input type="checkbox"/> Recovery <input type="checkbox"/> Injection	13. <input type="checkbox"/> Other (specify): .....	a) Closed Loop <input type="checkbox"/> Horizontal <input type="checkbox"/> Vertical b) Open Loop <input type="checkbox"/> Surface Discharge <input type="checkbox"/> Inj. of Water

Was a chemical/bacteriological sample submitted to KDHE?  Yes  No If yes, date sample was submitted: .....

Water well disinfected?  Yes  No

**8 TYPE OF CASING USED:**  Steel  PVC  Other ..... CASING JOINTS:  Glued  Clamped  Welded  Threaded

Casing diameter ..... **2** ..... in. to ..... **20** ..... ft., Diameter ..... in. to ..... ft., Diameter ..... in. to ..... ft.

Casing height above land surface ..... **0** ..... in. Weight ..... lbs./ft. Wall thickness or gauge No. **SCH40** .....

TYPE OF SCREEN OR PERFORATION MATERIAL:

Steel  Stainless Steel  Fiberglass  PVC  Other (Specify) .....

Brass  Galvanized Steel  Concrete tile  None used (open hole)

SCREEN OR PERFORATION OPENINGS ARE:

Continuous Slot  Mill Slot  Gauze Wrapped  Torch Cut  Drilled Holes  Other (Specify) .....

Louvered Shutter  Key Punched  Wire Wrapped  Saw Cut  None (Open Hole)

SCREEN-PERFORATED INTERVALS: From ..... **10** ..... ft. to ..... **20** ..... ft., From ..... ft. to ..... ft., From ..... ft. to ..... ft.

GRAVEL PACK INTERVALS: From ..... **8** ..... ft. to ..... **20** ..... ft., From ..... ft. to ..... ft., From ..... ft. to ..... ft.

**9 GROUT MATERIAL:**  Neat cement  Cement grout  Bentonite  Other .....

Grout Intervals: From ..... **1** ..... ft. to ..... **6** ..... ft., From ..... **6** ..... ft. to ..... **8** ..... ft., From ..... ft. to ..... ft.

Nearest source of possible contamination:

<input type="checkbox"/> Septic Tank	<input type="checkbox"/> Lateral Lines	<input type="checkbox"/> Pit Privy	<input type="checkbox"/> Livestock Pens	<input type="checkbox"/> Insecticide Storage
<input type="checkbox"/> Sewer Lines	<input type="checkbox"/> Cess Pool	<input type="checkbox"/> Sewage Lagoon	<input type="checkbox"/> Fuel Storage	<input type="checkbox"/> Abandoned Water Well
<input type="checkbox"/> Watertight Sewer Lines	<input type="checkbox"/> Seepage Pit	<input type="checkbox"/> Feedyard	<input type="checkbox"/> Fertilizer Storage	<input type="checkbox"/> Oil Well/Gas Well


Other (Specify) .....

Direction from well? ..... Distance from well? ..... ft.

10 FROM	TO	LITHOLOGIC LOG	FROM	TO	LITHO. LOG (cont.) or PLUGGING INTERVALS
0	0.5	Asphalt			
0.5	12.5	Silty Clay			
12.5	13	Limestone			
13	20	Silty Clay			

**11 CONTRACTOR'S OR LANDOWNER'S CERTIFICATION:** This water well was  constructed,  reconstructed, or  plugged under my jurisdiction and was completed on (mo-day-year) **3-20-19** ..... and this record is true to the best of my knowledge and belief.

Kansas Water Well Contractor's License No. **585** ..... This Water Well Record was completed on (mo-day-year) **4-15-19** ..... under the business name of **ASSOCIATED ENVIRONMENTAL INC.** Signature: *[Signature]*

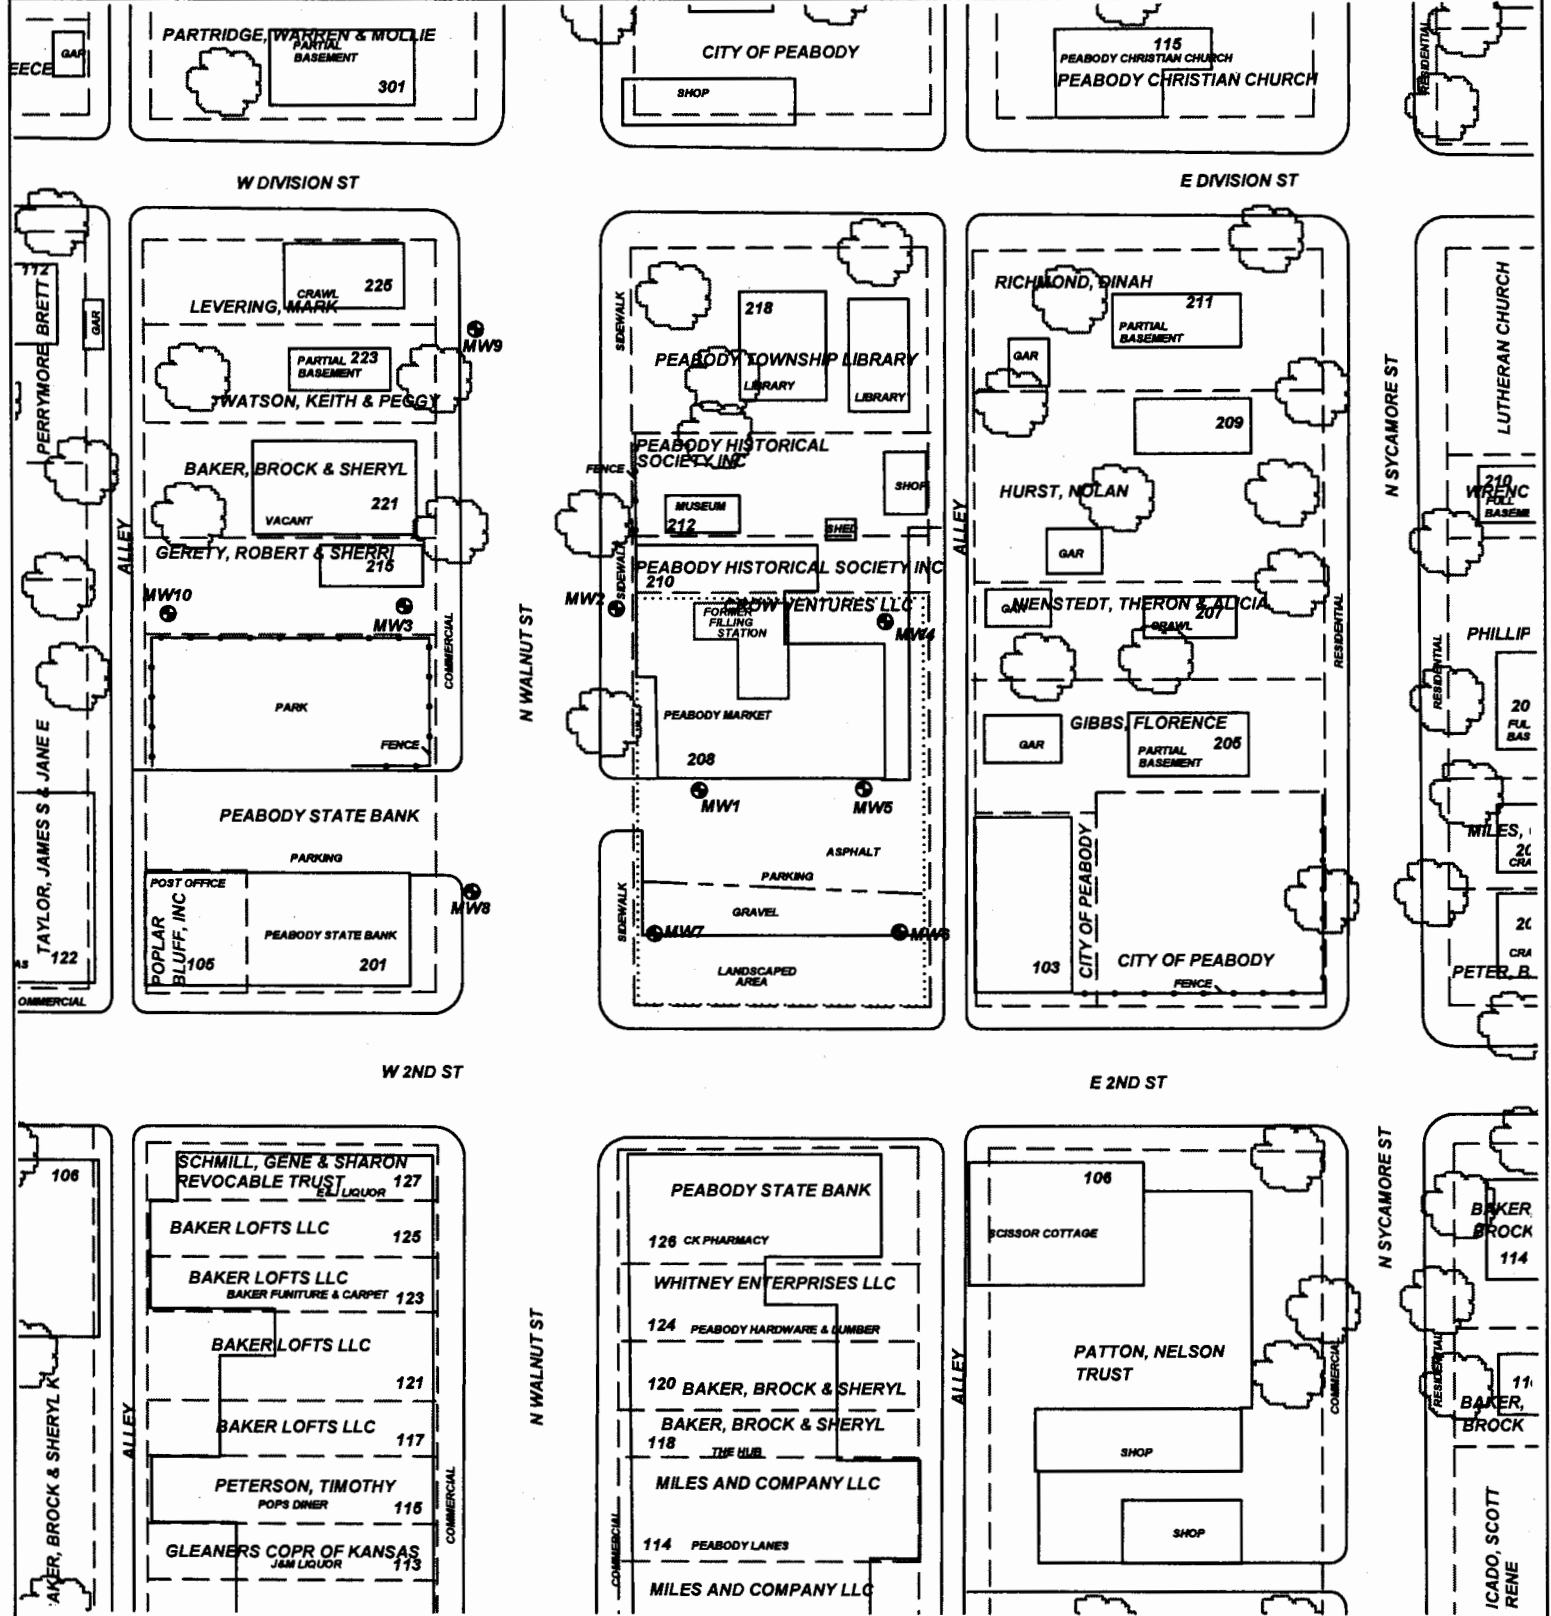

**PROJECT:** FORMER FILLING STATION-PEABODY  
**ADDRESS:** 208 N. WALNUT ST.  
**LOCATION:** PEABODY, KS  
**DRAWN BY:** B. STALNAKER      **DATE:** 11/6/16  
**REVISED BY:** C. ROE      **DATE:** 3/27/19  
**AEI JOB #:** TM218      **KDHE JOB #:** U5-057-14895

**TITLE:**  
**FIGURE 2.1**  
**AREA BASE MAP**  
**350' RADIUS**

**ASSOCIATED ENVIRONMENTAL INC.**

**LEGEND:**  
 ..... = SUBJECT PROPERTY  
 - - - - = PARCEL BOUNDARY  
 ● = MONITOR WELL

**SCALE:** 1" = 100'  
 0      50      100

**NOTES:**

