

WATER WELL PLUGGING RECORD Form WWC-5P

KSA 82a-1212 ID NO.

MW-7


1 LOCATION OF WATER WELL: Fraction NW ¼ NW¼ NW¼ SE ¼ Section Number 4 Township Number T 22 S Range Number 3 E W
 County: Marion

Street/Rural Address of Well Location; if unknown, distance & direction from nearest town or intersection: If at owner's address, check here 208 N.Walnut Peabody, Ks

Global Positioning Systems (GPS) information:
 Latitude: 38.16631 (in decimal degrees)
 Longitude: 97.10659 (in decimal degrees)
 Elevation: 1363.06 TOC
 Horizontal Datum: WGS84, NAD83, NAD27
 Collection Method: _____

2 WATER WELL OWNER: KDHE-BER
 RR#, St. Address, Box #: 1000 SW Jackson
 City, State ZIP Code: Topeka, KS 66612

GPS unit (Make/Model: _____)
 Digital Map/Photo, Topographic Map, Land Survey
 Est. Accuracy: < 3 m, 3-5 m, 5-15 m, > 15 m

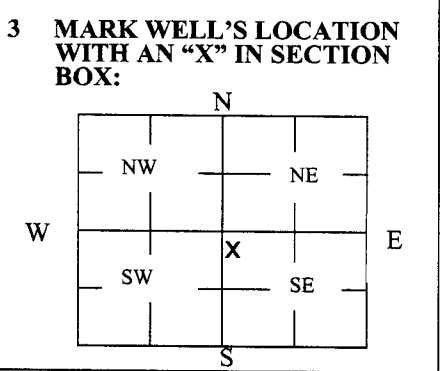

4 DEPTH OF WELL 20.07 ft.
 WELL'S STATIC WATER LEVEL 13.94 ft
 WELL WAS USED AS:
 Domestic Public Water Supply Dewatering
 Irrigation Oil Field Water Supply Monitoring
 Feedlot Domestic (Lawn & Garden) Injection Well
 Industrial Air Conditioning Other _____

Was a chemical/bacteriological sample submitted to Department? Yes No

5 TYPE OF BLANK CASING USED:

Steel RMP (SR) Wrought Fiberglass Other (Specify below) _____
 PVC ABS Asbestos-Cement Concrete Tile

Blank casing diameter 2 in. Was casing pulled? Yes No If yes, how much 3 Ft
 Casing height above or below land surface 36 in.

6 GROUT PLUG MATERIAL: Neat cement Cement grout Bentonite Other _____


Grout Plug Intervals: From 20.07 ft. to 3 ft., From _____ ft. to _____ ft., From _____ ft. to _____ ft.

What is the nearest source of possible contamination:
 Septic tank Seepage pit Fuel storage Other (specify below) _____
 Sewer lines Pit privy Fertilizer storage _____
 Watertight sewer lines Sewage lagoon Insecticide storage _____
 Lateral lines Feedyard Abandoned water well Oil well/Gas well Direction from well? East
 Cess pool Livestock pens How many feet? 250

FROM	TO	PLUGGING MATERIALS	FROM	TO	PLUGGING MATERIALS
0	0.5	Gravel			
0.5	3	Compacted silt/clay			
3	20.07	Hydrated Bentonite chips			Former Filling Station-Peabody U5-057-14895

7 CONTRACTOR'S OR LANDOWNER'S CERTIFICATION: This water well was plugged under my jurisdiction and was completed on (mo/day/year) 7/31/19 and this record is true to the best of my knowledge and belief. Kansas Water Well Contractor's License No. 585. This Water Well Record was completed on (mo/day/year) 8/30/19 under the business name of Associated Environmental, Inc. by (signature) [Signature]

Send one white copy to Kansas Department of Health & Environment, Geology Section, 1000 SW Jackson Street, Ste. 420, Topeka, KS 66612-1367. Send one copy to WATER WELL OWNER and retain one for your records.
 Visit us at <http://www.kdheks.gov/waterwell/index.html> Telephone 785-296-5524.

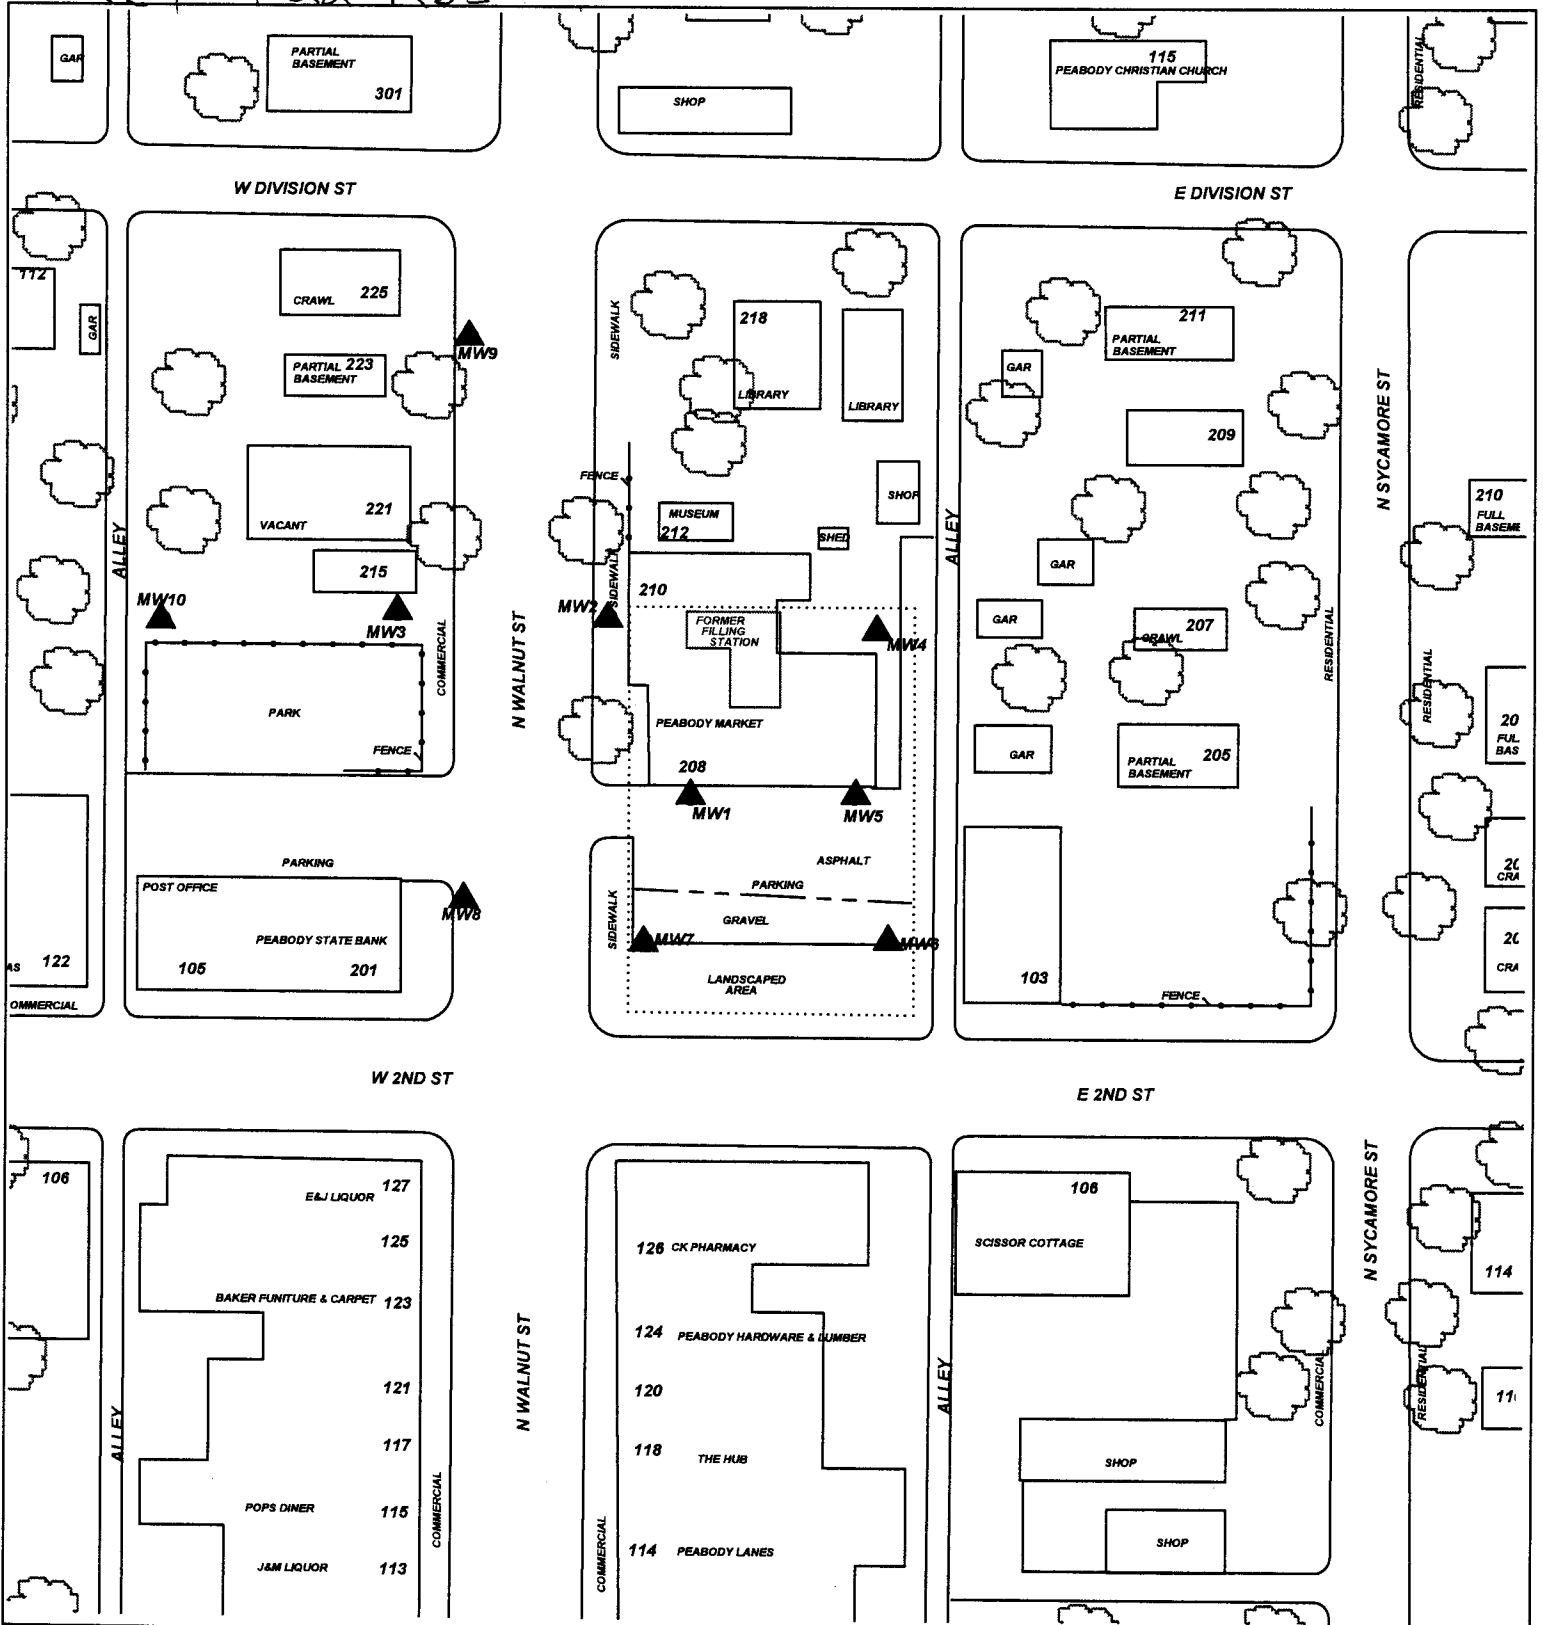

PROJECT: FORMER FILLING STATION-PEABODY

ADDRESS: 208 N. WALNUT ST.

LOCATION: PEABODY, KS

DRAWN BY: B. STALNAKER **DATE:** 11/6/16

REVISED BY: C. ROE **DATE:** 3/27/19

AEI JOB #: TM218 **KDHE JOB #:** U5-057-14895

TITLE:

**FIGURE 2.1
AREA BASE MAP
350' RADIUS**

**ASSOCIATED
ENVIRONMENTAL
INC.**

LEGEND:

..... = SUBJECT PROPERTY

⊙ = MONITOR WELL

▲ = Plugged Monitor Well

SCALE: 1" = 100'

0 50 100

NOTES: