

**WATER WELL PLUGGING RECORD Form WWC-5P**

KSA 82a-1212 ID NO.

MW-10


**1 LOCATION OF WATER WELL:** Fraction NE 1/4 NE 1/4 NE 1/4 SW 1/4 Section Number 4 Township Number T 22 S Range Number 3  E  W  
 County: Marion

Street/Rural Address of Well Location; if unknown, distance & direction from nearest town or intersection: If at owner's address, check here  223 N.Walnut Peabody, Ks

**Global Positioning Systems (GPS) information:**  
 Latitude: 38.16672 (in decimal degrees)  
 Longitude: 97.10744 (in decimal degrees)  
 Elevation: 1363.29 TOC  
 Horizontal Datum:  WGS84,  NAD83,  NAD27  
 Collection Method:

**2 WATER WELL OWNER:** KDHE-BER  
 RR#, St. Address, Box #: 1000 SW Jackson  
 City, State ZIP Code: Topeka, KS 66612

GPS unit (Make/Model: \_\_\_\_\_)  
 Digital Map/Photo,  Topographic Map,  Land Survey  
 Est. Accuracy:  < 3 m,  3-5 m,  5-15 m,  > 15 m

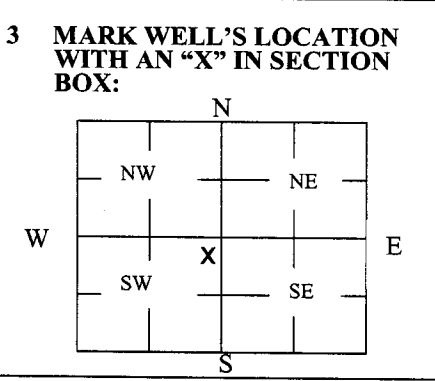

**4 DEPTH OF WELL** 20.05 ft.  
 WELL'S STATIC WATER LEVEL 12.74 ft  
 WELL WAS USED AS:  
 Domestic  Public Water Supply  Dewatering  
 Irrigation  Oil Field Water Supply  Monitoring  
 Feedlot  Domestic (Lawn & Garden)  Injection Well  
 Industrial  Air Conditioning  Other \_\_\_\_\_  
 Was a chemical/bacteriological sample submitted to Department? Yes  No

**5 TYPE OF BLANK CASING USED:**

Steel  RMP (SR)  Wrought  Fiberglass  Other (Specify below) \_\_\_\_\_  
 PVC  ABS  Asbestos-Cement  Concrete Tile

Blank casing diameter 2 in. Was casing pulled? Yes  No  If yes, how much 3 Ft  
 Casing height above or below land surface 36 in.

**6 GROUT PLUG MATERIAL:**  Neat cement  Cement grout  Bentonite  Other \_\_\_\_\_


Grout Plug Intervals: From 20.05 ft. to 3 ft., From \_\_\_\_\_ ft. to \_\_\_\_\_ ft., From \_\_\_\_\_ ft. to \_\_\_\_\_ ft.

What is the nearest source of possible contamination:  
 Septic tank  Seepage pit  Fuel storage  Other (specify below) \_\_\_\_\_  
 Sewer lines  Pit privy  Fertilizer storage  
 Watertight sewer lines  Sewage lagoon  Insecticide storage  
 Lateral lines  Feedyard  Abandoned water well Direction from well? West  
 Cess pool  Livestock pens  Oil well/Gas well How many feet? 150

FROM	TO	PLUGGING MATERIALS	FROM	TO	PLUGGING MATERIALS
0	3	Compacted silt/clay			
3	20.05	Hydrated Bentonite chips			
					Former Filling Station-Peabody
					U5-057-14895

**7 CONTRACTOR'S OR LANDOWNER'S CERTIFICATION:** This water well was plugged under my jurisdiction and was completed on (mo/day/year) 7/31/19 and this record is true to the best of my knowledge and belief. Kansas Water Well Contractor's License No. 585. This Water Well Record was completed on (mo/day/year) 8/30/19 under the business name of Associated Environmental, Inc. by (signature) [Signature]

Send one white copy to Kansas Department of Health & Environment, Geology Section, 1000 SW Jackson Street, Ste. 420, Topeka, KS 66612-1367. Send one copy to WATER WELL OWNER and retain one for your records.  
 Visit us at <http://www.kdheks.gov/waterwell/index.html> Telephone 785-296-5524.

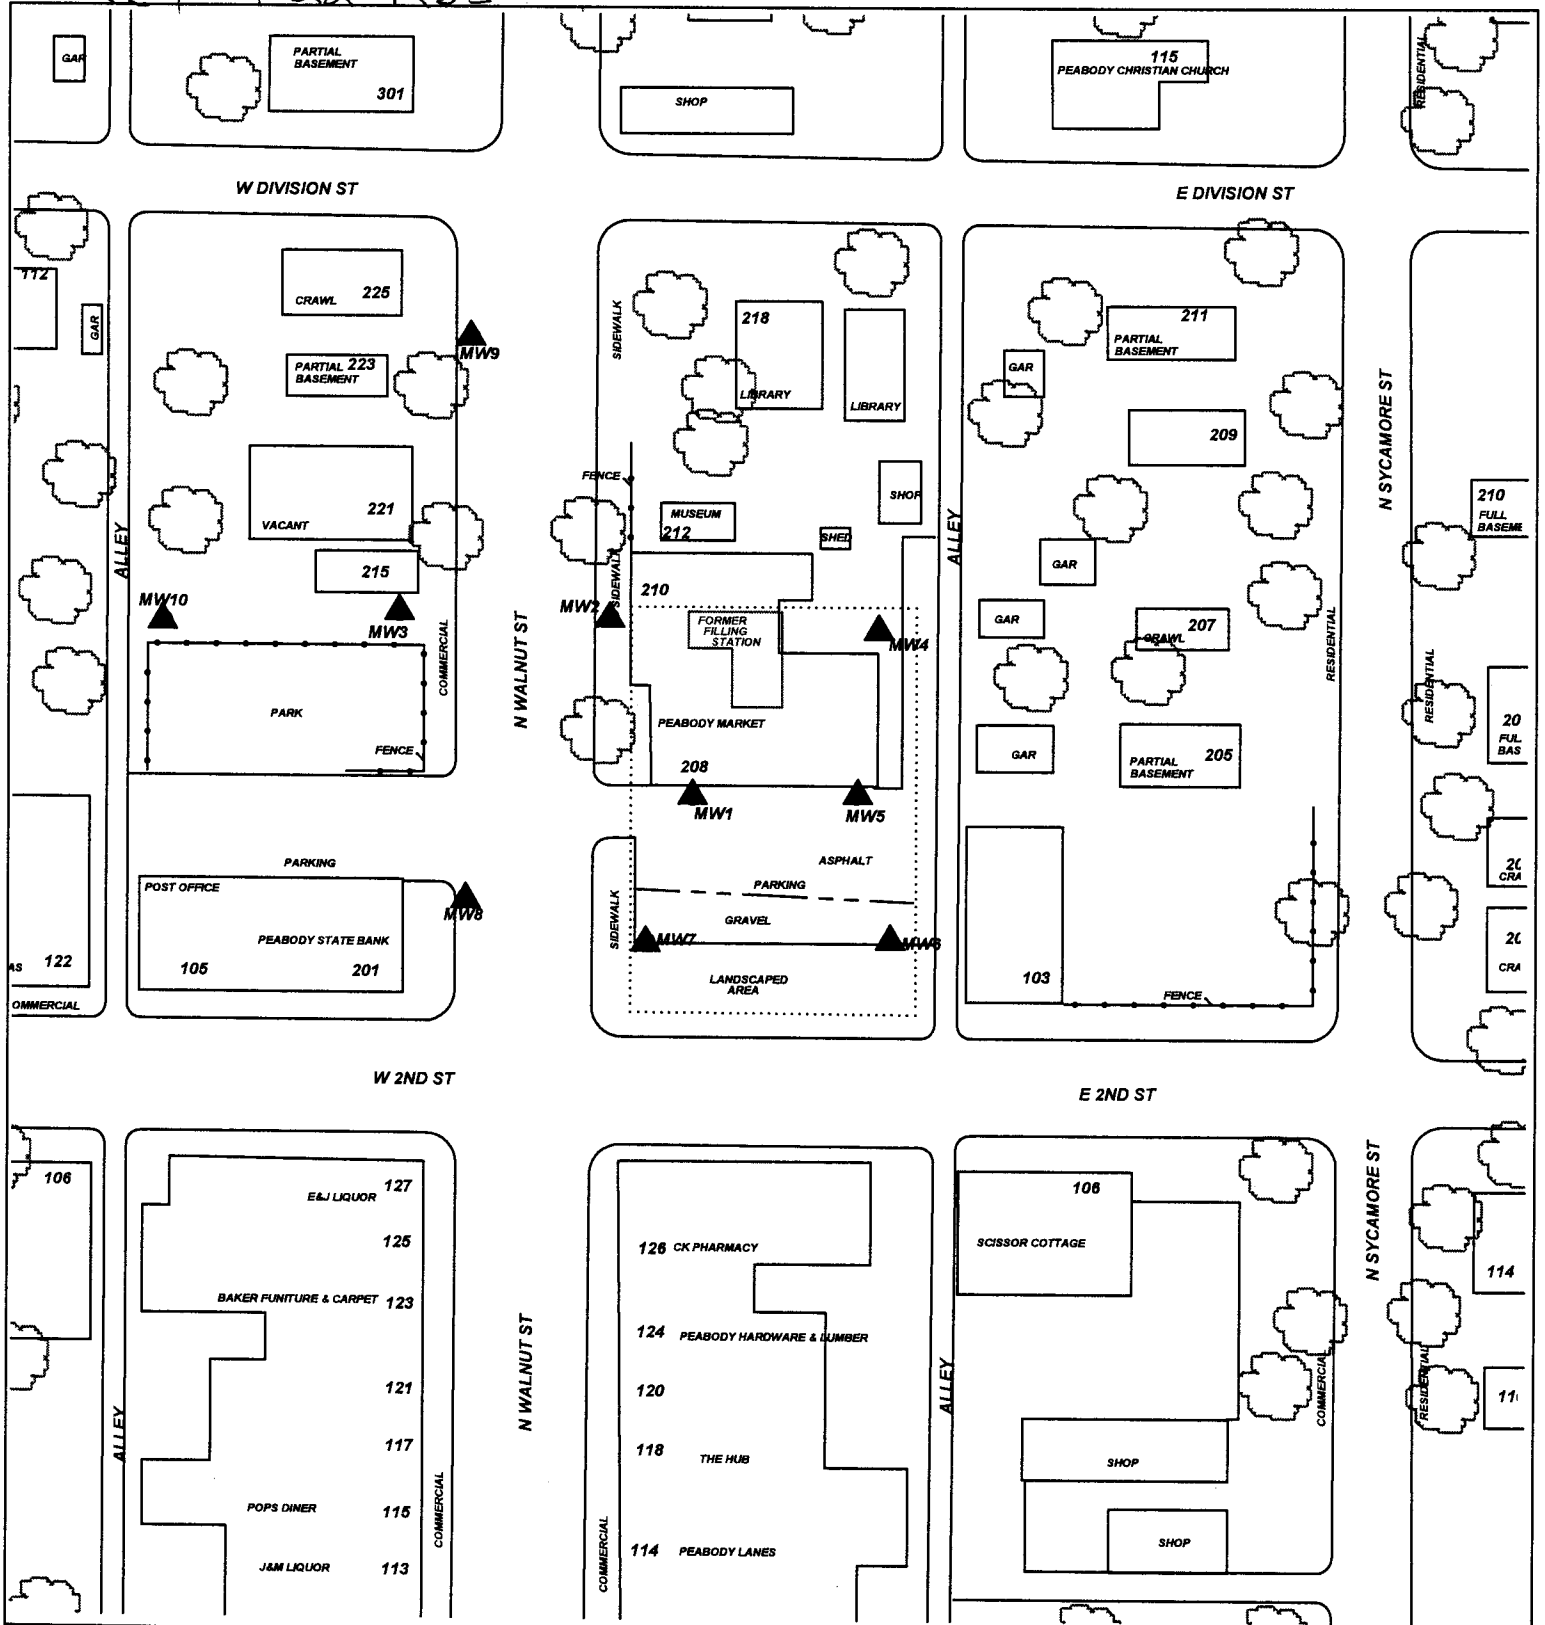

**PROJECT:** FORMER FILLING STATION-PEABODY  
**ADDRESS:** 208 N. WALNUT ST.  
**LOCATION:** PEABODY, KS  
**DRAWN BY:** B. STALNAKER **DATE:** 11/6/16  
**REVISED BY:** C. ROE **DATE:** 3/27/19  
**AEI JOB #:** TM218 **KDHE JOB #:** U5-057-14895

**TITLE:** **FIGURE 2.1**  
**AREA BASE MAP**  
**350' RADIUS**

**ASSOCIATED ENVIRONMENTAL INC.**

**LEGEND:**  
 ..... = SUBJECT PROPERTY  
 ● = MONITOR WELL  
 ▲ = Plugged Monitor Well

**SCALE:** 1" = 100'  
 0 50 100

**NOTES:**