

**WATER WELL RECORD Form WWC-5**

Original Record  Correction  Change in Well Use


Division of Water Resources App. No.  

Well ID

AS12

<b>1 LOCATION OF WATER WELL:</b> County: <b>Marion</b>	Fraction NW ¼ NW ¼ NW ¼ NE ¼	Section Number <b>4</b>	Township Number T <b>22</b> S	Range Number R <b>3</b> <input checked="" type="checkbox"/> E <input type="checkbox"/> W
---	---------------------------------	----------------------------	----------------------------------	---

<b>2 WELL OWNER:</b> Last Name: _____ First: _____ Business: <b>Kansas Dept. of Health &amp; Environment</b> Address: <b>Bureau of Environmental Remediation</b> Address: <b>1000 SW Jackson St., Suite 410</b> City: <b>Topeka</b> State: <b>KS</b> ZIP: <b>66612</b>	Street or Rural Address where well is located (if unknown, distance and direction from nearest town or intersection): If at owner's address, check here: <input type="checkbox"/> <b>911 N. Walnut St., Peabody</b>
--	--
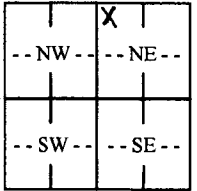
<b>3 LOCATE WELL WITH "X" IN SECTION BOX:</b> N  W E S 1 mile	<b>4 DEPTH OF COMPLETED WELL:</b> ..... <b>32</b> ..... ft. Depth(s) Groundwater Encountered: 1) ..... <b>18</b> ..... ft. 2) ..... ft. 3) ..... ft., or 4) <input type="checkbox"/> Dry Well WELL'S STATIC WATER LEVEL: ..... ft. <input type="checkbox"/> below land surface, measured on (mo-day-yr)..... <input type="checkbox"/> above land surface, measured on (mo-day-yr)..... Pump test data: Well water was ..... ft. after ..... hours pumping ..... gpm Well water was ..... ft. after ..... hours pumping ..... gpm Estimated Yield: ..... gpm Bore Hole Diameter: ..... <b>8</b> ..... in. to ..... <b>32</b> ..... ft. and ..... in. to ..... ft.	<b>5 Latitude:</b> ..... <b>38.17435</b> ..... (decimal degrees) <b>Longitude:</b> ..... <b>-97.10696</b> ..... (decimal degrees) <b>Horizontal Datum:</b> <input type="checkbox"/> WGS 84 <input checked="" type="checkbox"/> NAD 83 <input type="checkbox"/> NAD 27 <b>Source for Latitude/Longitude:</b> <input type="checkbox"/> GPS (unit make/model: <b>Spectra Precision Epp</b> ) (WAAS enabled? <input type="checkbox"/> Yes <input checked="" type="checkbox"/> No) <input type="checkbox"/> Land Survey <input type="checkbox"/> Topographic Map <input type="checkbox"/> Online Mapper: .....
		<b>6 Elevation:</b> <b>1389.60</b> ..... ft. <input checked="" type="checkbox"/> Ground Level <input type="checkbox"/> TOC <b>Source:</b> <input checked="" type="checkbox"/> Land Survey <input type="checkbox"/> GPS <input type="checkbox"/> Topographic Map <input type="checkbox"/> Other .....

**7 WELL WATER TO BE USED AS:**

1. Domestic: <input type="checkbox"/> Household <input type="checkbox"/> Lawn & Garden <input type="checkbox"/> Livestock	5. <input type="checkbox"/> Public Water Supply: well ID .....	10. <input type="checkbox"/> Oil Field Water Supply: lease .....
2. <input type="checkbox"/> Irrigation	6. <input type="checkbox"/> Dewatering: how many wells? .....	11. Test Hole: well ID .....
3. <input type="checkbox"/> Feedlot	7. <input type="checkbox"/> Aquifer Recharge: well ID .....	<input type="checkbox"/> Cased <input type="checkbox"/> Uncased <input type="checkbox"/> Geotechnical
4. <input type="checkbox"/> Industrial	8. <input type="checkbox"/> Monitoring: well ID .....	12. Geothermal: how many bores? .....
	9. Environmental Remediation: well ID <b>AS12</b> ..... <input checked="" type="checkbox"/> Air Sparge <input type="checkbox"/> Soil Vapor Extraction <input type="checkbox"/> Recovery <input type="checkbox"/> Injection	a) Closed Loop <input type="checkbox"/> Horizontal <input type="checkbox"/> Vertical b) Open Loop <input type="checkbox"/> Surface Discharge <input type="checkbox"/> Inj. of Water
		13. <input type="checkbox"/> Other (specify): .....

**Was a chemical/bacteriological sample submitted to KDHE?**  Yes  No If yes, date sample was submitted: .....

Water well disinfected?  Yes  No

**8 TYPE OF CASING USED:**  Steel  PVC  Other .....

Casing diameter ..... **2** ..... in. to ..... **30** ..... ft., Diameter ..... in. to ..... ft.  
Casing height above land surface ..... **10.68** ..... in. Weight ..... lbs./ft. Wall thickness or gauge No. **Sch. 40**.....

**CASING JOINTS:**  Glued  Clamped  Welded  Threaded

**TYPE OF SCREEN OR PERFORATION MATERIAL:**  
 Steel  Stainless Steel  Fiberglass  PVC  Other (Specify) .....

Brass  Galvanized Steel  Concrete tile  None used (open hole)

**SCREEN OR PERFORATION OPENINGS ARE:**  
 Continuous Slot  Mill Slot  Gauze Wrapped  Torch Cut  Drilled Holes  Other (Specify) .....

Louvered Shutter  Key Punched  Wire Wrapped  Saw Cut  None (Open Hole)

**SCREEN-PERFORATED INTERVALS:** From **30** ..... ft. to **32** ..... ft., From ..... ft. to ..... ft. to ..... ft.

**GRAVEL PACK INTERVALS:** From **15** ..... ft. to **32** ..... ft., From ..... ft. to ..... ft. to ..... ft.

**9 GROUT MATERIAL:**  Neat cement  Cement grout  Bentonite  Other .....


Grout Intervals: From **3** ..... ft. to **15** ..... ft., From ..... ft. to ..... ft., From ..... ft. to ..... ft.

**Nearest source of possible contamination:**  
 Septic Tank  Lateral Lines  Pit Privy  Livestock Pens  Insecticide Storage  
 Sewer Lines  Cess Pool  Sewage Lagoon  Fuel Storage  Abandoned Water Well  
 Watertight Sewer Lines  Seepage Pit  Feedyard  Fertilizer Storage  Oil Well/Gas Well  
 Other (Specify) .....

Direction from well? ..... Distance from well? ..... ft.

10 FROM	TO	LITHOLOGIC LOG	FROM	TO	LITHO. LOG (cont.) or PLUGGING INTERVALS
0	0.5	Limestone Gravel			
0.5	8	Clay, sl. silty, Dark Brown			KDHE Project
8	16	Sand, vf-m w/tr. c, Lt. Brown			
16	25	Clay, Lt. Gray			U5-057-13295
25	32	Clay, Tan mottled Lt. Gray			U5-057-13451
					Notes:

**11 CONTRACTOR'S OR LANDOWNER'S CERTIFICATION:** This water well was  constructed,  reconstructed, or  plugged under my jurisdiction and was completed on (mo-day-year) **10/10/2019**..... and this record is true to the best of my knowledge and belief. Kansas Water Well Contractor's License No. **527**..... This Water Well Record was completed on (mo-day-year) **3/20/2020**..... under the business name of **GeoCore, LLC**..... Signature *[Signature]*

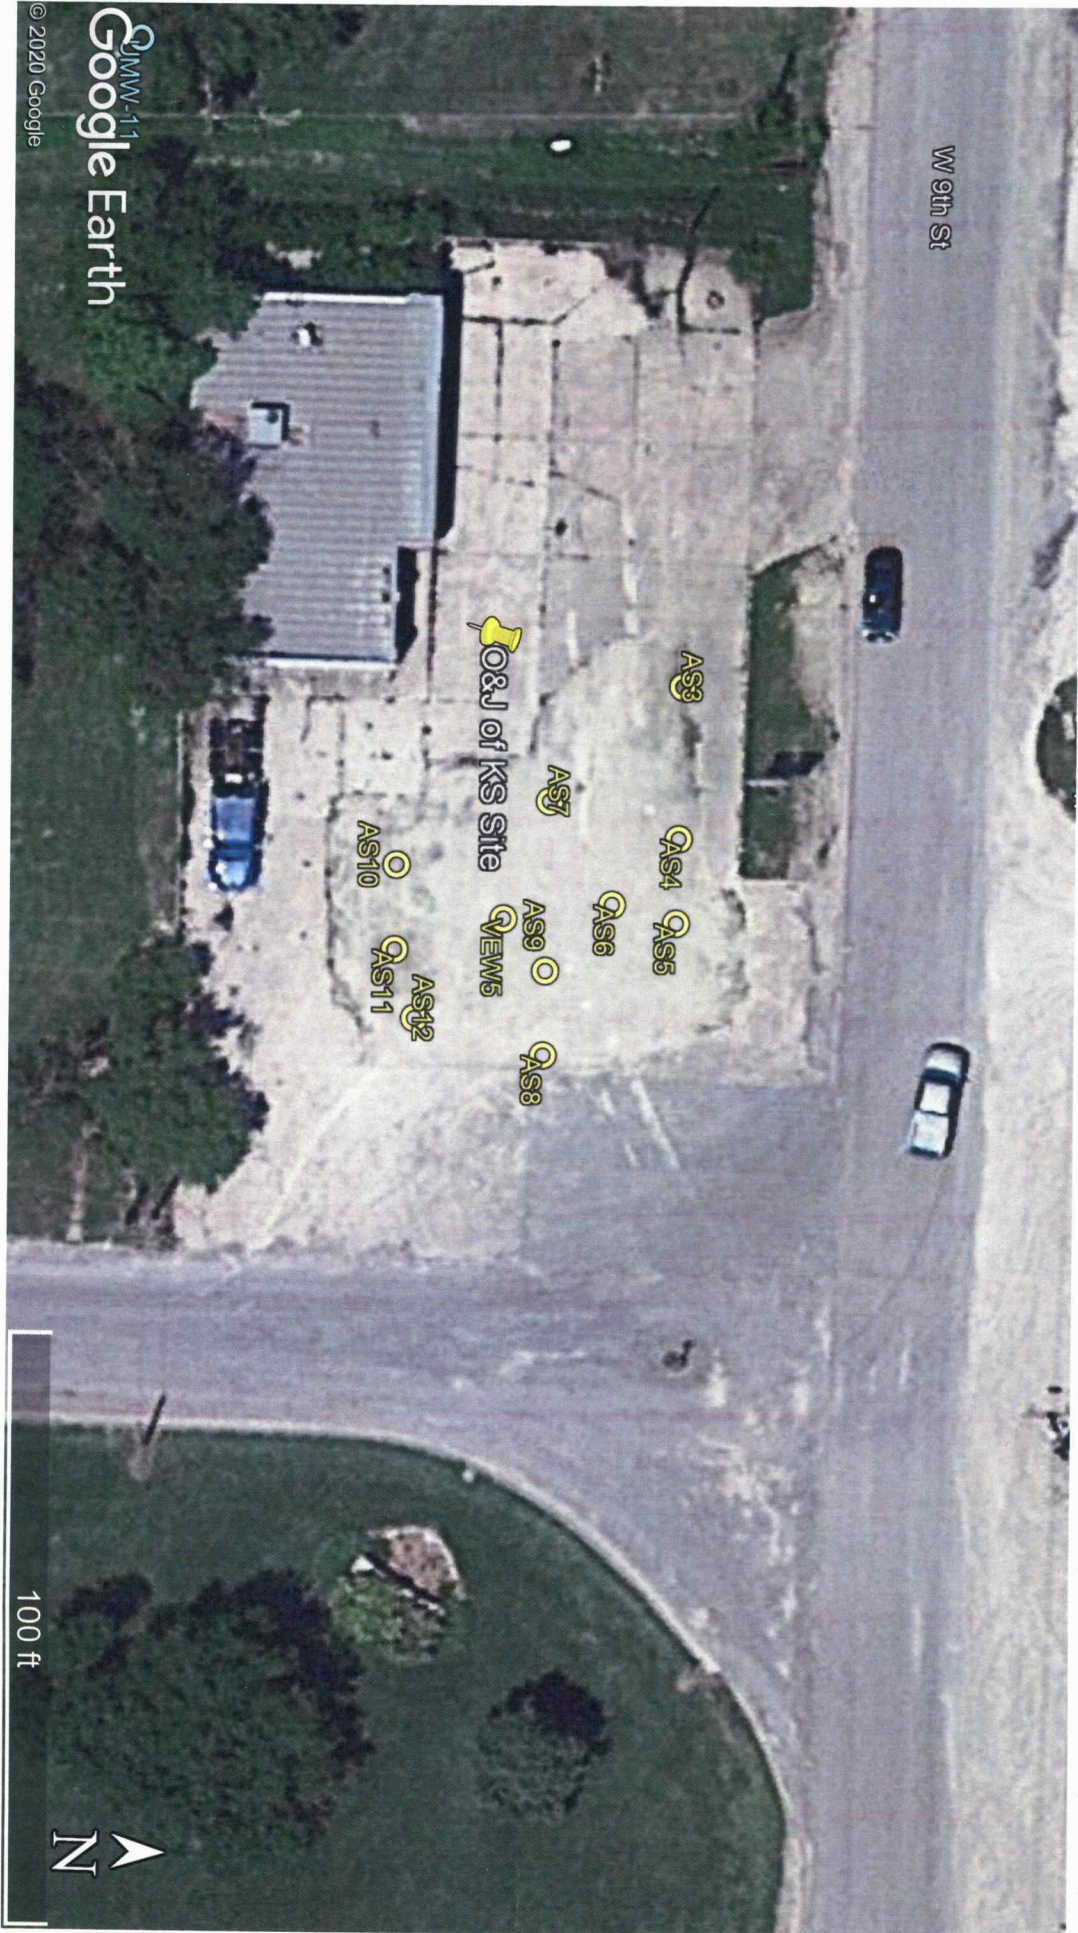

© 2020 Google  
 Google Earth

O & J of Kansas, 911 N. Walnut St., Peabody, Kansas – KDHE Project Codes: U5-057-13295 and U5-057-13451

GPS Coordinates:

AS3: 38.17447, -97.10716  
 AS4: 38.17447, -97.10707  
 AS5: 38.17447, -97.10702  
 AS6: 38.17444, -97.10703  
 AS7: 38.17441, -97.10709

AS8: 38.17441, -97.10694  
 AS9: 38.17441, -97.10699  
 AS10: 38.17434, -97.10705  
 AS11: 38.17434, -97.10700  
 AS12: 38.17435, -97.10696

QEW5: 38.17439, -97.10702

4-T22-R3E  
 Wyanon