


1 LOCATION OF WATER WELL: County: Marion Fraction: Se 1/4 Sw 1/4 Se 1/4 Section Number: 21 Township Number: T 22 S Range Number: R 4 E

Distance and direction from nearest town or city street address of well if located within city?  
0.1 E 3 1/2 #5 Peabody

2 WATER WELL OWNER: Howard Wedell  
 RR#, St. Address, Box #: RR 3  
 City, State, ZIP Code: Peabody, KS  
 Board of Agriculture, Division of Water Resources  
 Application Number:

3 LOCATE WELL'S LOCATION WITH AN "X" IN SECTION BOX:

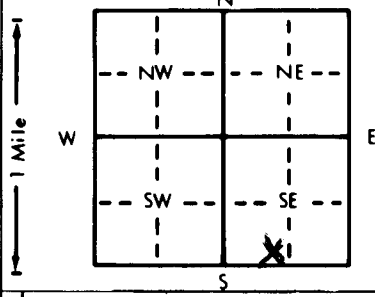

4 DEPTH OF COMPLETED WELL: 292 ft. ELEVATION:  
 Depth(s) Groundwater Encountered: 1 ft. 2. 2 ft. 3. 2-2-95 ft.  
 WELL'S STATIC WATER LEVEL: 32 ft. below land surface measured on mo/day/yr  
 WELL WATER TO BE USED AS:  
 1 Domestic 3 Feedlot 6 Oil field water supply 9 Dewatering 12 Other (Specify below)  
 2 Irrigation 4 Industrial 7 Lawn and garden only 10 Monitoring well  
 Was a chemical/bacteriological sample submitted to Department? Yes     No X If yes, mo/day/yr sample was submitted      
 Water Well Disinfected? Yes X No    

5 TYPE OF BLANK CASING USED:  
 1 Steel 3 RMP (SR) 5 Wrought iron 8 Concrete tile CASING JOINTS: Glued X Clamped      
 2 PVC 4 ABS 6 Asbestos-Cement 9 Other (specify below) Welded      
 7 Fiberglass Threaded    

Blank casing diameter: 5 in. to 60 ft., Dia. 12 in. to 60 ft., Dia. 12 in. to 60 ft.  
 Casing height above land surface: 12 in., weight CLASS 160 lbs./ft. Wall thickness or gauge No. 214

TYPE OF SCREEN OR PERFORATION MATERIAL:  
 1 Steel 3 Stainless steel 5 Fiberglass 8 RMP (SR) 10 Asbestos-cement  
 2 Brass 4 Galvanized steel 6 Concrete tile 9 ABS 11 Other (specify)      
 12 None used (open hole)

SCREEN OR PERFORATION OPENINGS ARE:  
 1 Continuous slot 3 Mill slot 5 Gauzed wrapped 8 Saw cut 11 None (open hole)  
 2 Louvered shutter 4 Key punched 6 Wire wrapped 9 Drilled holes  
 7 Torch cut 10 Other (specify)    

SCREEN-PERFORATED INTERVALS: From 60 ft. to 80 ft., From     ft. to     ft.  
 GRAVEL PACK INTERVALS: From     ft. to     ft., From     ft. to     ft.

6 GROUT MATERIAL: 1 Neat cement 2 Cement grout 3 Bentonite 4 Other      
 Grout Intervals: From 0 ft. to 20 ft., From     ft. to     ft., From     ft. to     ft.

What is the nearest source of possible contamination:  
 1 Septic tank 4 Lateral lines 7 Pit privy 10 Livestock pens 14 Abandoned water well  
 2 Sewer lines 5 Cess pool 8 Sewage lagoon 11 Fuel storage 15 Oil well/Gas well  
 3 Watertight sewer lines 6 Seepage pit 9 Feedyard 12 Fertilizer storage 16 Other (specify below)  
 13 Insecticide storage

Direction from well? S How many feet? 100 +

FROM	TO	LITHOLOGIC LOG	FROM	TO	PLUGGING INTERVALS
0	17	Clay			
17	22	Lime			
22	50	Yellow Shale + mixed Clay			
50	62	Blue + Gray Shale			
62	72	Red Shale			
72		Water			
72	80	Gray Rock			

7 CONTRACTOR'S OR LANDOWNER'S CERTIFICATION: This water well was (1) constructed, (2) reconstructed, or (3) plugged under my jurisdiction and was completed on (mo/day/year) 2-2-95 and this record is true to the best of my knowledge and belief. Kansas Water Well Contractor's License No. 189 This Water Well Record was completed on (mo/day/yr) 2-2-95 under the business name of Backhoe Drilling by (signature) Backhoe Drilling

INSTRUCTIONS: Use typewriter or ball point pen. PLEASE PRESS FIRMLY and PRINT clearly. Please fill in blanks, underline or circle the correct answers. Send top three copies to Kansas Department of Health and Environment, Bureau of Water, Topeka, Kansas 66620-0001. Telephone: 913-296-5545. Send one to WATER WELL OWNER and retain one for your records.