


1 LOCATION OF WATER WELL: Fraction  $\frac{1}{4}$   $\frac{1}{4}$   $\frac{1}{4}$  Section Number 4 Township Number T 22 S Range Number R 4 E/W

Distance and direction from nearest town or city street address of well if located within city?  
5 Miles EAST

2 WATER WELL OWNER: DON ROSINE  
RR#, St. Address, Box #: RR 1 Box 72  
City, State, ZIP Code: Peabody KS 66866  
Board of Agriculture, Division of Water Resources  
Application Number:

3 LOCATE WELL'S LOCATION WITH AN "X" IN SECTION BOX: 4 DEPTH OF COMPLETED WELL: 84 ft. ELEVATION: 60 ft.

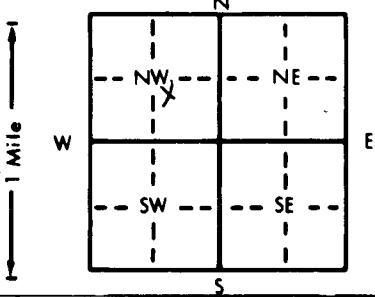

Depth(s) Groundwater Encountered 1. 60 ft. 2. ft. 3. ft.  
WELL'S STATIC WATER LEVEL 22 ft. below land surface measured on mo/day/yr 10-15-91  
Pump test data: Well water was ft. after hours pumping gpm  
Est. Yield gpm: Well water was ft. after hours pumping gpm  
Bore Hole Diameter 8 in. to 8.4 ft., and in. to ft.  
WELL WATER TO BE USED AS:  
1 Domestic 3 Feedlot 6 Oil field water supply 9 Dewatering 12 Other (Specify below)  
2 Irrigation 4 Industrial 7 Lawn and garden only 10 Observation well  
Was a chemical/bacteriological sample submitted to Department? Yes No; If yes, mo/day/yr sample was submitted Water Well Disinfected? Yes No

5 TYPE OF BLANK CASING USED:  
1 Steel 3 RMP (SR) 5 Wrought iron 8 Concrete tile CASING JOINTS: Glued Clamped  
2 PVC 4 ABS 6 Asbestos-Cement 9 Other (specify below) Welded  
7 Fiberglass Threaded

Blank casing diameter 5 in. to 8.4 ft. Dia in. to ft. Dia in. to ft.  
Casing height above land surface 1.6 in., weight 51.0 26 lbs./ft. Wall thickness or gauge No.

TYPE OF SCREEN OR PERFORATION MATERIAL:  
1 Steel 3 Stainless steel 5 Fiberglass 8 RMP (SR) 10 Asbestos-cement  
2 Brass 4 Galvanized steel 6 Concrete tile 9 ABS 11 Other (specify)  
12 None used (open hole)

SCREEN OR PERFORATION OPENINGS ARE:  
1 Continuous slot 3 Mill slot 5 Gauzed wrapped 8 Saw cut 11 None (open hole)  
2 Louvered shutter 4 Key punched 6 Wire wrapped 9 Drilled holes  
7 Torch cut 10 Other (specify)

SCREEN-PERFORATED INTERVALS: From 8.4 ft. to 6.4 ft. From ft. to ft.  
GRAVEL PACK INTERVALS: From 8.4 ft. to 2.4 ft. From ft. to ft.

6 GROUT MATERIAL: 1 Neat cement 2 Cement grout 3 Bentonite 4 Other  
Grout Intervals: From 0 ft. to 2.4 ft. From 2.4 ft. to 0.3 ft. From ft. to ft.

What is the nearest source of possible contamination:  
1 Septic tank 4 Lateral lines 7 Pit privy 10 Livestock pens 14 Abandoned water well  
2 Sewer lines 5 Cess pool 8 Sewage lagoon 11 Fuel storage 15 Oil well/Gas well  
3 Watertight sewer lines 6 Seepage pit 9 Feedyard 12 Fertilizer storage 16 Other (specify below)  
13 Insecticide storage

Direction from well? SOUTH-EAST How many feet? 150

FROM	TO	LITHOLOGIC LOG	FROM	TO	LITHOLOGIC LOG
0	3	Soil			
3	10	clay			
10	15	dark shale			
15	17	lime			
17	28	light shaled clay			
28	32	shale blue			
32	40	gray shale			
40	45	lime			
45	53	shale			
53	64	lime water			
64	84	shale			

7 CONTRACTOR'S OR LANDOWNER'S CERTIFICATION: This water well was (1) constructed, (2) reconstructed, or (3) plugged under my jurisdiction and was completed on (mo/day/year) 10-16-91 and this record is true to the best of my knowledge and belief. Kansas Water Well Contractor's License No. 512 This Water Well Record was completed on (mo/day/yr) 10-20-91 under the business name of JEFFREY Well Drilling by (signature) Jeff B Jeffrey

INSTRUCTIONS: Use typewriter or ball point pen. PLEASE PRESS FIRMLY and PRINT clearly. Please fill in blanks, underline or circle the correct answers. Send top three copies to Kansas Department of Health and Environment, Bureau of Water Protection, Topeka, Kansas 66620-7320, Telephone: 913-862-9360. Send one to WATER WELL OWNER and retain one for your records.