

Sent 7-7-77

USE TYPEWRITER OR BALL POINT PEN—PRESS FIRMLY, PRINT CLEARLY.

T R EW sec 1/4 1/4 1/4 No.


WATER WELL RECORD
KSA 82a-1201-1215

Kansas State Dept. Of Health
(Water Well Contractors)
Forbes-Bldg. 740
Topeka, Kansas 66620

NW NW NW

1 Location of well: County Marion Township name Summit Fraction NW 1/4 Section number 30 Town number 22 Range number 4E

Distance and direction from nearest town or city: 2 1/2 S + 3 E
Street address of well location if in city: Peabody
3 Owner of well: Earl Knust
Address: RR1 Peabody, Ks

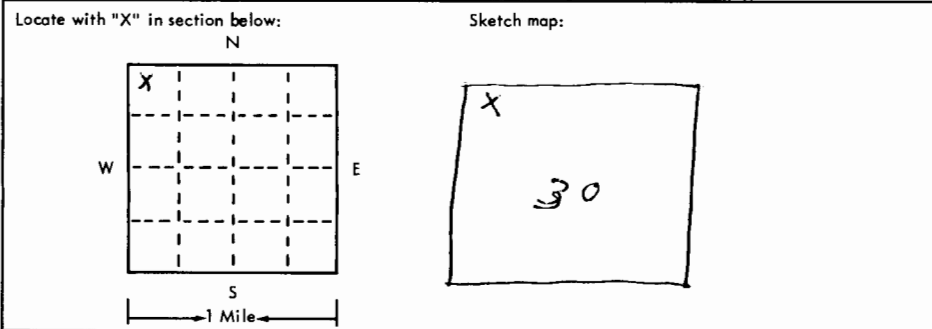

4 Well depth: 65 ft. Date of completion 5/19/77
Well diameter 9 in.
5 Cable tool Rotary Driven Dug
 Hollow rod Jetted Bored Reverse rotary
6 Use: Domestic Public supply Industry
 Irrigation Air conditioning Commercial
 Test well
7 Casing: Material Plastic Height: above/below
Threaded Welded Surface 12 in.
Diam. _____ Weight _____ lbs./ft. _____
5 in. to 65 ft. depth Drive shoe? Yes No
_____ in. to _____ ft. depth

2	Type and color of material	From	To
	Top Soil (Dark Black)	0	5
	Red clay	5	8
	Yellow Clay	8	14
	Yellow Limestone	14	30
	White Limestone	30	52
	Water gravel (Blue black white)	52	58
	Blue clay	58	65

8 Screen: Manufacturer SUNFLOWER
Type Plastic Dia. 5"
Slot/gauze 1/8" Length 30'
Set between 35 ft. and 65 ft.
Fittings: _____
Gravel pack Yes No Size range of material _____
9 Static water level: 30 ft. below land surface Date 5/19/77
10 Pumping level below land surfaces: Bailing
30 ft. after 1 hrs. pumping 15 g.p.m.
_____ ft. after _____ hrs. pumping _____ g.p.m.
Estimated maximum yield 15 g.p.m.
11 Water sample submitted:
 Yes No Date _____
12 Well head completion: 12
 Pitless adapter Inches above grade
13 Well grouted? Yes No
 Neat cement Bentonite _____
Depth: From 0 ft. to 14 ft.
14 Nearest source of possible contamination: MNC
ft. 350 Direction _____ Type sewer line
Well disinfected upon completion? Yes No
15 Pump: Not installed
Manufacturer's name _____
Model number _____ HP _____ Volts _____
Length of drop pipe _____ ft. capacity _____ g.m.p.
Type:
 Submersible Turbine
 Jet Reciprocating
 Centrifugal Other

16 Remarks: elevation
Topography:
 Hill
 Slope
 Upland
 Valley
(use a second sheet if needed)

17 Water well contractor's certification:
This well was drilled under my jurisdiction and this report is true to the best of my knowledge and belief.
Sellers Drilling 270
Business name _____ License No. _____
Address RR1 Florence
Signed Robert Sellers _____
Authorized representative

2 2
4E
30
NW NW NW