


1 LOCATION OF WATER WELL: County: Marion Fraction: SW 1/4 SE 1/4 NW 1/4 Section Number: 33 Township Number: 22 S Range Number: R 5 E

Distance and direction from nearest town or city street address of well if located within city?  
In City Burns 408 Cementary Ln.

2 WATER WELL OWNER: Harold Goodwin  
 RR#, St. Address, Box #: 408 W. Cementary Ln. Board of Agriculture, Division of Water Resources  
 City, State, ZIP Code: Burns, KS. 66840 Application Number:

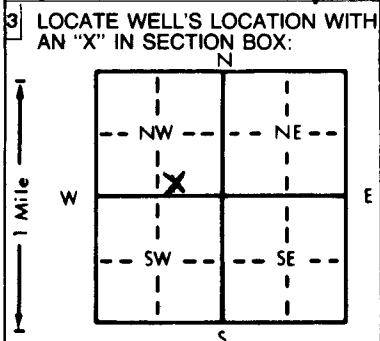

4 DEPTH OF COMPLETED WELL: 76 ft. ELEVATION:  
 Depth(s) Groundwater Encountered: 1. 72 ft. 2. ft. 3. ft.  
 WELL'S STATIC WATER LEVEL: 22 ft. below land surface measured on 11-24-98  
 Pump test data: Well water was ft. after hours pumping gpm  
 Est. Yield: 40 gpm; Well water was ft. after hours pumping gpm  
 Bore Hole Diameter: 1 1/2 in. to 7.2 ft., and in. to ft.  
 WELL WATER TO BE USED AS:  
 5 Public water supply 8 Air conditioning 11 Injection well  
 1 Domestic 3 Feedlot 6 Oil field water supply 9 Dewatering 12 Other (Specify below)  
 2 Irrigation 4 Industrial 7 Lawn and garden only 10 Monitoring well  
 Was a chemical/bacteriological sample submitted to Department? Yes No X; If yes, mo/day/yr sample was submitted  
 Water Well Disinfected? Yes X No

5 TYPE OF BLANK CASING USED:  
 1 Steel 3 RMP (SR) 5 Wrought iron 8 Concrete tile CASING JOINTS: Glued X Clamped  
 2 PVC 4 ABS 6 Asbestos-Cement 9 Other (specify below) Welded  
 Blank casing diameter: 5 in. to 30 ft. Dia. in. to ft. Dia. in. to ft.  
 Casing height above land surface: 12 in., weight CLASS 160 lbs./ft. Wall thickness or gauge No. 214  
 TYPE OF SCREEN OR PERFORATION MATERIAL:  
 1 Steel 3 Stainless steel 5 Fiberglass 7 PVC 10 Asbestos-cement  
 2 Brass 4 Galvanized steel 6 Concrete tile 9 ABS 11 Other (specify)  
 SCREEN OR PERFORATION OPENINGS ARE:  
 1 Continuous slot 3 Mill slot 5 Gauzed wrapped 8 Saw cut 11 None (open hole)  
 2 Louvered shutter 4 Key punched 7 Torch cut 9 Drilled holes  
 SCREEN-PERFORATED INTERVALS: From 50 ft. to 76 ft., From ft. to ft.  
 GRAVEL PACK INTERVALS: From 22 ft. to 76 ft., From ft. to ft.

6 GROUT MATERIAL: 1 Neat cement 2 Cement grout 3 Bentonite 4 Other  
 Grout Intervals: From 2 ft. to 22 ft., From ft. to ft., From ft. to ft.  
 What is the nearest source of possible contamination:  
 1 Septic tank 4 Lateral lines 7 Pit privy 10 Livestock pens 14 Abandoned water well  
 2 Sewer lines 5 Cess pool 8 Sewage lagoon 11 Fuel storage 15 Oil well/Gas well  
 3 Watertight sewer lines 6 Seepage pit 9 Feedyard 12 Fertilizer storage 16 Other (specify below)  
 13 Insecticide storage  
 Direction from well? E How many feet? 75+

FROM	TO	LITHOLOGIC LOG	FROM	TO	PLUGGING INTERVALS
0	17	Clay			
17	47	Lime mixed Flint Rock			
47	65	Red-yellow Shale			
65	72	lime Hard			
72	73	Water			
73	76	Gray Rock			

7 CONTRACTOR'S OR LANDOWNER'S CERTIFICATION This water well was (1) constructed, (2) reconstructed, or (3) plugged under my jurisdiction and was completed on (mo/day/year) 11-24-98 and this record is true to the best of my knowledge and belief. Kansas Water Well Contractor's License No. 120 This Water Well Record was completed on (mo/day/yr) 12-10-98 under the business name of Backhoe Drilling by (signature) Paul H. Bushman

OFFICE USE ONLY  
T  
R  
EW  
SEC.  
1/4  
1/4  
1/4