


1 LOCATION OF WATER WELL: Marion	FRACTION SE 1/4 NW 1/4 SE 1/4	Section Number 33	Township Number T 22 S	Range Number R 5E E/W
--	---	-----------------------------	----------------------------------	---------------------------------

Distance and direction from nearest town or city street address of well if located within city:
130' E. & 150' N. of center of Franklin & Main St. Burns, Kansas

WATER WELL OWNER: BURNS COOP RR#, ST. ADDRESS, BOX #: P.O. Box CITY, STATE, ZIP CODE: Burns, Kansas 66840	Board of Agriculture, Division of Water Resource Application Number:
--	---

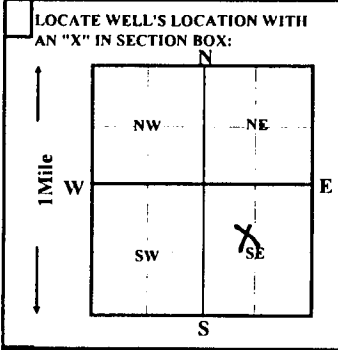

4 DEPTH OF COMPLETED WELL 40 ft.	ELEVATION:	Depth(s) groundwater Encountered 1 ft. 2 ft. 3 ft.	WELL'S STATIC WATER LEVEL 28.58 FT. BELOW LAND SURFACE MEASURED ON 6-24-2002 mo/day/yr
Pump test data: Well water was		ft. after	hours pumping
Est. Yield		gpm: Well water was	ft. after
Bore Hole Diameter 7 in. to 40 ft.		ft. and	in. to
WELL WATER TO BE USED AS:			
1 Domestic		3 Feedlot	6 Oil field water supply
2 Irrigation		4 Industrial	7 Lawn and garden only
5 Public water supply		8 Air conditioning	11 Injection well
9 Dewatering		12 Other (Specify below)	
10 Monitoring well			
Was a chemical/bacteriological sample submitted to Department? Yes <input type="checkbox"/> No <input checked="" type="checkbox"/> ; If yes, mo/day/yr sample was submitted			
Water Well Disinfected? Yes <input type="checkbox"/> No <input checked="" type="checkbox"/>			

5 TYPE OF CASING USED:	5 Wrought iron	8 Concrete tile	CASING JOINTS:
1 Steel	3 RMP (SR)	6 Asbestos-Cement	9 Other (Specify below)
2 PVC	4 ABS	7 Fiberglass	Glued
Blank casing Diameter 2 in. to 30 ft., Dia			Clamped
Casing height above land surface 2.85 ft. in., weight - 965 lbs. / ft.			Welded
TYPE OF SCREEN OR PERFORATION MATERIAL:			Threaded
1 Steel	3 Stainless Steel	5 Fiberglass	<input checked="" type="checkbox"/>
2 Brass	4 Galvanized steel	6 Concrete tile	9 ABS
SCREEN OR PERFORATION OPENING ARE:			11 None (open hole)
1 Continuous slot	3 Mill slot	5 Gauzed wrapped	8 Saw cut .030
2 Louvered shutter	4 Key punched	6 Wire wrapped	9 Drilled holes
SCREEN-PERFORATION INTERVALS:			10 Other (specify)
GRAVEL PACK INTERVALS:	from 30 ft. to 40 ft., From	ft. to	ft.
	from	ft. to	ft.
	from 23 ft. to 40 ft., From	ft. to	ft.
	from	ft. to	ft.

6 GROUT MATERIAL:	1 Neat cement	2 Cement grout	3 Bentonite	4 Other bentonite hole plug
Grout Intervals: From	ft. to	ft. From	ft. to	ft. From 0 ft. to 23 ft.
What is the nearest source of possible contamination:				
1 Septic tank	4 Lateral lines	7 Pit privy	10 Livestock pens	14 Abandon water well
2 Sewer lines	5 Cess pool	8 Sewage lagoon	11 Fuel storage	15 Oil well/Gas well
3 Watertight sewer lines	6 Seepage pit	9 Feedyard	12 Fertilizer storage	16 Other (specify below)
			13 Insecticide storage	None Apparent

Direction from well?		How many feet?			
FROM	TO	LITHOLOGIC LOG	FROM	TO	PLUGGING INTERVALS
0	5	topsoil & brown clay			
5	18	shale, gray-green, soft weathered			
18	20	shale, tan w/ some limestone			
20	25	shale, tan, w/ limestone layers			
25	30	limestone, tan gray, cherty, very hard, w/ white crystals			
30	37	limestone, tan, soft			
37	40	limestone, tan w/ white crystals and chert, very hard, bottom .8', very hard brown limestone			
40	42	shale, tan, soft			

7 CONTRACTOR'S OR LANDOWNER'S CERTIFICATION: This water well was (1) constructed, (2) reconstructed, or (3) plugged under my jurisdiction and was completed on (mo/day/year) 6-24-2002 and this record is true to the best of my knowledge and belief. Kansas Water Well Contractor's License No. 236 This Water Well Record was completed on (mo/day/yr) 7-1-2002	
Under the business name of Harp Well & Pump Service, Inc by (signature) <i>Todd S. Harp</i>	