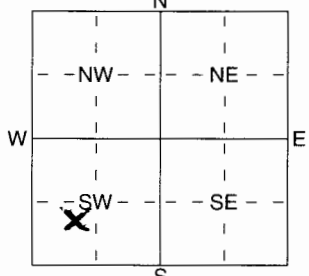


1 LOCATION OF WATER WELL: Fraction Ne 1/4 Sw 1/4 Sw 1/4 Section Number 22 Township Number T 22 S Range Number R 5-0
 County: Marion

Distance and direction from nearest town or city street address of well if located within city?
1/2 N Burns

2 WATER WELL OWNER: Steve Stucky
 RR#, St. Address, Box #: Box 144 Board of Agriculture, Division of Water Resources
 City, State, ZIP Code: Burns, Ks. 66240 Application Number:

3 LOCATE WELL'S LOCATION WITH AN "X" IN SECTION BOX:  4 DEPTH OF COMPLETED WELL 92 ft. ELEVATION:
 Depth(s) Groundwater Encountered 33 ft. 2 92 ft. 3 12-15-09 ft.
 WELL'S STATIC WATER LEVEL 33 ft. below land surface measured on mo/day/yr
 Pump test data: Well water was 20 ft. after 20 hours pumping 20 gpm
 Est. Yield 20 gpm: Well water was 20 ft. after 20 hours pumping 20 gpm
 WELL WATER TO BE USED AS: 5 Public water supply 8 Air conditioning 11 Injection well
 1 Domestic 3 Feedlot 6 Oil field water supply 9 Dewatering 12 Other (Specify below)
 2 Irrigation 4 Industrial 7 Domestic (lawn & garden) 10 Monitoring well
 Was a chemical/bacteriological sample submitted to Department? Yes No; If yes, mo/day/yr sample was submitted
 Water Well Disinfected? Yes No

5 TYPE OF BLANK CASING USED: 1 Steel 3 RMP (SR) 5 Wrought iron 8 Concrete tile CASING JOINTS: Glued Clamped
 2 PVC 4 ABS 6 Asbestos-Cement 9 Other (specify below) Welded
 7 Fiberglass Threaded
 Casing height above land surface 12 in., weight Clas 92.162 lbs./ft. Wall thickness or gauge No 214
 TYPE OF SCREEN OR PERFORATION MATERIAL: 7 PVC 10 Asbestos-Cement
 1 Steel 3 Stainless Steel 5 Fiberglass 8 RMP (SR) 11 Other (Specify)
 2 Brass 4 Galvanized Steel 6 Concrete tile 9 ABS 12 None used (open hole)
 SCREEN OR PERFORATION OPENINGS ARE: 5 Gauzed wrapped 8 Saw cut 11 None (open hole)
 1 Continuous slot 3 Mill slot 6 Wire wrapped 9 Drilled holes
 2 Louvered shutter 4 Key punched 7 Torch cut 10 Other (specify) ft.

 What is the nearest source of possible contamination:
 1 Septic tank 4 Lateral lines 7 Pit privy 10 Livestock pens 14 Abandoned water well
 2 Sewer lines 5 Cess pool 8 Sewage lagoon 11 Fuel storage 15 Oil well/Gas well
 3 Watertight sewer lines 6 Seepage pit 9 Feedyard 12 Fertilizer storage 16 Other (specify below)
 13 Insecticide storage
 Direction from well? How many feet?

FROM	TO	LITHOLOGIC LOG	FROM	TO	PLUGGING INTERVALS
0	42	Lime + Mixed Flint			
42	65	yellow Shale			
65	75	Red Shale			
75	82	Lime			
82	83	Water			
83	90	lime			
90	92	Gray Beck			

7 CONTRACTOR'S OR LANDOWNER'S CERTIFICATION: This water well was (1) constructed, (2) reconstructed, or (3) plugged under my jurisdiction and was completed on (mo/day/year) 12-15-09 and this record is true to the best of my knowledge and belief. Kansas Water Well Contractor's Licence No TR0 This Water Well Record was completed on (mo/day/yr) 12-16-09 under the business name of Baukhoe Drilling by (signature) Paul H Baukhoe

INSTRUCTIONS: Use typewriter or ball point pen. PLEASE PRESS FIRMLY and PRINT clearly. Please fill in blanks, underline or circle the correct answers. Send top three copies to Kansas Department of Health and Environment, Bureau of Water, Geology Section, 1000 SW Jackson St., Suite 420, Topeka, Kansas 66612-1367. Telephone 785-296-5522. Send one to WATER WELL OWNER and retain one for your records. Fee of \$5.00 for each constructed well.