Sept 5-17-77

USE TYPEWRITER OR BALL POINT PEN-PRESS FIRMLY, PRINT CLEARLY.

WATER WELL RECORD
KSA 82a-1201-1215

Kansas Department of Health and Environment-Division of Environment
(Water well Contractors)
Topeka, Kansas 66620

SW SW NW

1. Location of well:	County: Marion	Fraction: South West	Section number: 21	Township number: T 22 S	Range number: R 5 E (E) W

2. Distance and direction from nearest town or city: 1½ mi north
Street address of well location if in city: Burns 4

3. Owner of well: Clayton Hochn
R.R. or street: RFD 2
City, state, zip code: Burns 66840

4. Locate with "X" in section below:

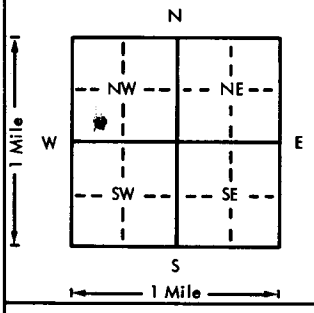

Sketch map:

6. Bore hole dia. 11 in. Completion date 3-10-77
Well depth 130 ft. MNC

7. [X] Cable tool ___ Rotary ___ Driven ___ Dug
___ Hollow rod ___ Jetted ___ Bored ___ Reverse rotary

8. Use: [X] Domestic ___ Public supply ___ Industry
___ Irrigation ___ Air conditioning [X] Stock
___ Lawn ___ Oil field water ___ Other

9. Casing: Material plus
Threaded ___ Welded ___
RMP ___ PVC [X]
Dio. 12 in. to ___ ft. depth
Dia. ___ in. to ___ ft. depth
Height: Above or below Surface 18 in.
Weight Sch 40 lbs./ft.
Wall Thickness: inches or gage No. Sch 40

10. Screen: Manufacturer's name Home Made
Type plus Dia. 12
Slot/gauze ___ Length 40 ft
Set between 90 MNC ft. and 130 ft.
___ ft. and ___ ft.
Gravel pack? [X] Size range of material ___

11. Static water level: 60 ft. below land surface Date 3-10-77 mo./day/yr.

12. Pumping level below land surfaces:
___ ft. after ___ hrs. pumping ___ g.p.m.
___ ft. after ___ hrs. pumping ___ g.p.m.
Estimated maximum yield ___ g.p.m.

13. Water sample submitted: ___ Yes [X] No Date ___ mo./day/yr.

14. Well head completion: ___ Pitless adapter 18 inches above grade

15. Well grouted? [X]
With: [X] Neat cement ___ Bentonite ___ Concrete
Depth: From 0 ft. to 30 ft.

16. Nearest source of possible contamination: ft. [X] Direction West Type Brown
Well disinfected upon completion? [X] Yes ___ No

17. Pump: [X] Not installed
Manufacturer's name ___
Model number ___ HP ___ Volts ___
Length of drop pipe ___ ft. capacity ___ g.p.m.
Type:
___ Submersible ___ Turbine
___ Jet ___ Reciprocating
___ Centrifugal ___ Other

5. Type and color of material

	From	To
Humbo	0	15
Lime	20	35
Soap Stone	8	43
Lime	10	53
Shale	7	60
Red Rock	12	72
Brown Shale	18	90
Lime	10	100
Shale Blue	8	108
Lime	10	118
Shale	4	122
Lime	8	130

(Use a second sheet if needed)

25 ft Cement top
Hole bottom
Grout
Grine Sea Hole
Pump seat
Mine Well

18. Elevation:

Topography:
___ Hill
___ Slope
[X] Upland
___ Valley

19. Remarks: This well is for a Grade A milk barn

20. Water well contractor's certification:
This well was drilled under my jurisdiction and this report is true to the best of my knowledge and belief.
Schimp's Waterwell 228
Business name License No.
Address Marion
William Schimp Date 3-10
Authorized representative

T 22 S R 5 E (E) W Sec 21 1/4 SW 1/4 SW 1/4 SW 1/4

Forward the white, blue and pink copies to the Department of Health and Environment

Form WWC-5

MI-1023