


1 LOCATION OF WATER WELL: County: Chase Fraction: NW 1/4 SE 1/4 NE 1/4 Section Number: 1 Township Number: T 22 S Range Number: R 6 E

Distance and direction from nearest town or city street address of well if located within city?

2 WATER WELL OWNER: SANDY CUNNINGHAM Dr.
 RR#, St. Address, Box #: #2 Thrasher St & Marconi Dr. Board of Agriculture, Division of Water Resources
 City, State, ZIP Code: New Orleans, LA, 70124-4108 Application Number:

3 LOCATE WELL'S LOCATION WITH AN "X" IN SECTION BOX:

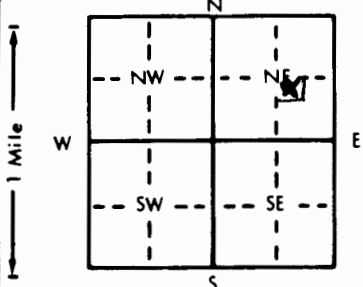

4 DEPTH OF COMPLETED WELL: 102 ft. ELEVATION: 70 ft. below land surface measured on NOV 2-97

Depth(s) Groundwater Encountered 1. 96 ft. 2. 96 ft. 3. 96 ft.
 WELL'S STATIC WATER LEVEL: 70 ft. below land surface measured on NOV 2-97
 Pump test data: Well water was _____ ft. after _____ hours pumping _____ gpm
 Est. Yield 20 t gpm: Well water was _____ ft. after _____ hours pumping _____ gpm
 Bore Hole Diameter: 8 5/8 in. to 26 ft., and 7 in. to 102 ft.
 WELL WATER TO BE USED AS:
 1 Domestic 3 Feedlot 6 Oil field water supply 9 Dewatering 12 Other (Specify below)
 2 Irrigation 4 Industrial 7 Lawn and garden only 10 Monitoring well
 Was a chemical/bacteriological sample submitted to Department? Yes No X If yes, mo/day/yr sample was submitted _____
 Water Well Disinfected? Yes No

5 TYPE OF BLANK CASING USED:
 1 Steel 3 RMP (SR) 6 Asbestos-Cement 9 Other (specify below)
 2 PVC 4 ABS 7 Fiberglass
 Blank casing diameter: 5 in. to 70 ft. Dia. in. to _____ ft. Dia. in. to _____ ft.
 Casing height above land surface: 18 in., weight _____ lbs./ft. Wall thickness or gauge No. SDR-26

TYPE OF SCREEN OR PERFORATION MATERIAL:
 1 Steel 3 Stainless steel 5 Fiberglass 8 RMP (SR)
 2 Brass 4 Galvanized steel 6 Concrete tile 9 ABS 11 Other (specify) _____
 10 Asbestos-cement
 12 None used (open hole)

SCREEN OR PERFORATION OPENINGS ARE:
 1 Continuous slot 3 Mill slot 5 Gauzed wrapped 8 Saw cut 11 None (open hole)
 2 Louvered shutter 4 Key punched 6 Wire wrapped 9 Drilled holes
 7 Torch cut 10 Other (specify) _____

SCREEN-PERFORATED INTERVALS: From 70 ft. to 102 ft., From _____ ft. to _____ ft.
 GRAVEL PACK INTERVALS: From NONE ft. to _____ ft., From _____ ft. to _____ ft.

6 GROUT MATERIAL: Neat cement 2 Cement grout 3 Bentonite 4 Other _____
 Grout Intervals: From 3 ft. to 26 ft., From _____ ft. to _____ ft., From _____ ft. to _____ ft.

What is the nearest source of possible contamination:
 1 Septic tank 4 Lateral lines 7 Pit privy 10 Livestock pens 14 Abandoned water well
 2 Sewer lines 5 Cess pool Proposed Sewage lagoon 11 Fuel storage 15 Oil well/Gas well
 3 Watertight sewer lines 6 Seepage pit 9 Feedyard 12 Fertilizer storage 16 Other (specify below) _____
 13 Insecticide storage

Direction from well? South How many feet? 100

FROM	TO	LITHOLOGIC LOG	FROM	TO	PLUGGING INTERVALS
0	2	Top Soil			
2	10	LIME TAN			
10	14	Shale Gray			
14	32	LIME TAN			
32	42	Shale Lite Gray			
42	45	LIME Gray			
45	47	Shale Gray			
47	51	LIME Gray			
51	56	Shale Gray			
56	81	LIME Flint Lite			
81	90	Shale Gray Calc.			
90	92	LIME Gray			
92	96	Shale Green			
96	97	Trac. LIME			
97	102	LIME hd Gray			

7 CONTRACTOR'S OR LANDOWNER'S CERTIFICATION: This water well was (1) constructed, (2) reconstructed, or (3) plugged under my jurisdiction and was completed on (mo/day/year) NOV 2-97 and this record is true to the best of my knowledge and belief. Kansas Water Well Contractor's License No. 218 This Water Well Record was completed on (mo/day/yr) Nov 20 97 under the business name of ZINN Water Well Dng. by (signature) Joseph A. Zinn

INSTRUCTIONS: Use typewriter or ball point pen. PLEASE PRESS FIRMLY and PRINT clearly. Please fill in blanks, underline or circle the correct answers. Send top three copies to Kansas Department of Health and Environment, Bureau of Water, Topeka, Kansas 66620-0001. Telephone: 913-296-5545. Send one to WATER WELL OWNER and retain one for your records.

OFFICE USE ONLY
T
R
EW
SEC.