


1 LOCATION OF WATER WELL: County: Chase Fraction: NW 1/4 NE 1/4 NE 1/4 Section Number: 8 Township Number: T 22 S Range Number: R 6 E

Distance and direction from nearest town or city street address of well if located within city?
1/2 mile North & 1/4 mile West of Wosevu

2 WATER WELL OWNER: John Butcher
 RR#, St. Address, Box #: 9134 Tomashaw Board of Agriculture, Division of Water Resources
 City, State, ZIP Code: Lexington, Ks 66219 Application Number:

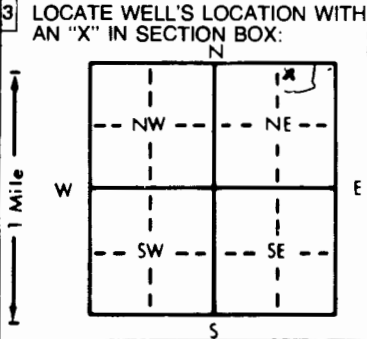

4 DEPTH OF COMPLETED WELL: 70 ft. ELEVATION:
 Depth(s) Groundwater Encountered 1. 28 ft. 2. ft. 3. ft.
 WELL'S STATIC WATER LEVEL: 19 ft. below land surface measured on mo/day/yr MAY 12 99
 Pump test data: Well water was ft. after hours pumping gpm
 Est. Yield 25 gpm; Well water was ft. after hours pumping gpm
 Bore Hole Diameter: 8 5/8 in. to 24 ft., and 6 7/8 in. to 70 ft.
 WELL WATER TO BE USED AS:
 Domestic Feedlot Oil field water supply Dewatering Other (Specify below)
 Irrigation Industrial Lawn and garden only Monitoring well
 Was a chemical/bacteriological sample submitted to Department? Yes No If yes, mo/day/yr sample was submitted
 Water Well Disinfected? Yes No

5 TYPE OF BLANK CASING USED:
 1 Steel 3 RMP (SR) 6 Asbestos-Cement 9 Other (specify below) CASING JOINTS: Glued Clamped
 2 PVC 4 ABS 7 Fiberglass Welded
 Blank casing diameter: 5 in. to 20 ft., Dia. in. to ft., Dia. in. to ft.
 Casing height above land surface: 18 in., weight lbs./ft. Wall thickness or gauge No.
 TYPE OF SCREEN OR PERFORATION MATERIAL:
 1 Steel 3 Stainless steel 5 Fiberglass 7 PVC 10 Asbestos-cement
 2 Brass 4 Galvanized steel 6 Concrete tile 8 RMP (SR) 11 Other (specify)
 SCREEN OR PERFORATION OPENINGS ARE:
 1 Continuous slot 3 Mill slot 5 Gauzed wrapped 8 Saw cut 11 None (open hole)
 2 Louvered shutter 4 Key punched 6 Wire wrapped 9 Drilled holes
 7 Torch cut 10 Other (specify)
 SCREEN-PERFORATED INTERVALS: From 26 ft. to 70 ft., From ft. to ft.
 GRAVEL PACK INTERVALS: From 24 ft. to 70 ft., From ft. to ft.

6 GROUT MATERIAL: 1 Neat cement 2 Cement grout 3 Bentonite 4 Other
 Grout intervals: From 3 ft. to 24 ft., From ft. to ft., From ft. to ft.
 What is the nearest source of possible contamination:
 1 Septic tank 4 Lateral lines 7 Pit privy 10 Livestock pens 14 Abandoned water well
 2 Sewer lines 5 Cess pool 8 Sewage lagoon 11 Fuel storage 15 Oil well/Gas well
 3 Watertight sewer lines 6 Seepage pit 9 Feedyard 12 Fertilizer storage 16 Other (specify below)
 13 Insecticide storage
 Direction from well? North West How many feet? 75

FROM	TO	LITHOLOGIC LOG	FROM	TO	PLUGGING INTERVALS
0	2	Top Soil			
2	18	Red Slab			
18	28	Shale TAN			
28	45	Red-Brown Shale			
45	48	LIME Gray			
48	49	Shale Gray			
49	57	LIME / Flint			
57	59	Shale Gray			
59	64	LIME white			
64	70	Shale Gray			

7 CONTRACTOR'S OR LANDOWNER'S CERTIFICATION: This water well was (1) constructed, (2) reconstructed, or (3) plugged under my jurisdiction and was completed on (mo/day/year) MAY 12 99 and this record is true to the best of my knowledge and belief. Kansas Water Well Contractor's License No. 218 This Water Well Record was completed on (mo/day/yr) Jun 1 99 under the business name of Zinn Water Well Dring by (signature) Joseph A. Zinn

INSTRUCTIONS: Use typewriter or ball point pen. PLEASE PRESS FIRMLY and PRINT clearly. Please fill in blanks, underline or circle the correct answers. Send top three copies to Kansas Department of Health and Environment, Bureau of Water, Topeka, Kansas 66620-0001. Telephone: 913-296-5545. Send one to WATER WELL OWNER and retain one for your records.

OFFICE USE ONLY