

East Well

WATER WELL RECORD

Form WWC-5


Division of Water Resources App. No.

[Empty box for application number]

1 LOCATION OF WATER WELL: County: Chase Fraction: Se 1/4 Nw 1/4 Ne 1/4 Section Number: 29 Township No. T 22 S Range Number R 6 E W

Street/Rural Address of Well Location; if unknown, distance & direction from nearest town or intersection: Apprix 5 E Burns Global Positioning System (GPS) information: Latitude: Longitude: Elevation: Datum: Collection Method: Est. Accuracy:

2 WATER WELL OWNER: Meat Hook Ranch RR#, Street Address, Box #: 1612 60th City, State, ZIP Code: Peabody, KS, 66861

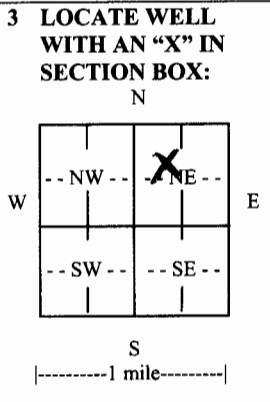

3 LOCATE WELL WITH AN 'X' IN SECTION BOX: 4 DEPTH OF COMPLETED WELL: 103 ft. Depth(s) Groundwater Encountered: 95 ft. WELL'S STATIC WATER LEVEL: 22 ft. below land surface measured on 4-9-10 Pump test data: Well water was 5+ gpm EST. YIELD: 5+ gpm Bore Hole Diameter: 8 1/2 in. to 20 ft. and 6 1/2 in. to 103 ft. WELL WATER TO BE USED AS: [] Domestic [] Feedlot [] Oil field water supply [] Dewatering [] Injection well [] Irrigation [] Industrial [] Domestic-lawn & garden [] Monitoring well [] Yes [X] No for cattle

5 TYPE OF CASING USED: [] Steel [X] PVC [] Other CASING JOINTS: [] Glued [] Clamped [] Welded [] Threaded Casing diameter: 5 in. to 60 ft. Diameter: 1 1/2 in. to 20 ft. Casing height above land surface: 12 ft. Weight: SPP 26 lbs./ft. Wall thickness or gauge No. 2.14

TYPE OF SCREEN OR PERFORATION MATERIAL: [] Steel [] Stainless Steel [X] PVC [] Other (Specify) [] Brass [] Galvanized Steel [] None used (open hole) SCREEN OR PERFORATION OPENINGS ARE: [] Continuous slot [] Mill slot [] Gauze wrapped [] Torch cut [] Drilled holes [] None (open hole) [] Louvered shutter [] Key punched [] Wire wrapped [X] Saw cut [] Other (specify)

SCREEN-PERFORATED INTERVALS: From 60 ft. to 103 ft. GRAVEL PACK INTERVALS: From 60 ft. to 103 ft.

6 GROUT MATERIAL: [] Neat cement [] Cement grout [X] Bentonite [] Other Grout Intervals: From 0 ft. to 30 ft.

What is the nearest source of possible contamination: [] Septic tank [] Lateral lines [] Pit privy [] Livestock pens [] Insecticide storage [] Other (specify below) [] Sewer lines [] Cesspool [] Sewage lagoon [] Fuel storage [] Abandoned water well [] Watertight sewer lines [] Seepage pit [] Feedyard [] Fertilizer storage [] Oil well/gas well Direction from well: Distance from well: None within 2 mi

Table with 6 columns: FROM, TO, LITHOLOGIC LOG, FROM, TO, LITHO. LOG (cont.) or PLUGGING INTERVALS. Rows include: 0-6 Clay, 6-45 Lime Hard, 45-46 Some Water, 46-95 Hard Lime + mixed Flint, 95-96 Water, 96-103 Hard Gray Slate

7 CONTRACTOR'S OR LANDOWNER'S CERTIFICATION: This water well was [X] constructed, [] reconstructed, or [] plugged under my jurisdiction and was completed on (mo/day/year) 7-9-10 and this record is true to the best of my knowledge and belief. Kansas Water Well Contractor's License No. 187 This Water Well Record was completed on (mo/day/year) 7-9-10 under the business name of Backhus Drilling by (signature) Jack Backhus

INSTRUCTIONS: Use typewriter or ball point pen. PLEASE PRESS FIRMLY and PRINT clearly. Please fill in blanks and check the correct answers. Send three copies (white, blue, pink) to Kansas Department of Health and Environment, Bureau of Water, Geology Section, 1000 SW Jackson St., Suite 420, Topeka, Kansas 66612-1367. Telephone 785-296-5522. Send one copy to WATER WELL OWNER and retain one for your records. Include fee of \$5.00 for each constructed well. Visit us at http://www.kdheks.gov/waterwell/index.html.