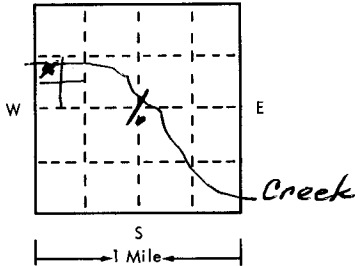


USE TYPEWRITER OR BALL
POINT PEN-PRESS FIRMLY,
PRINT CLEARLY.

WATER WELL RECORD
KSA 82a-1201-1215

T R EW sec 1/4 1/4 1/4 No.

Kansas State Dept. Of Health
(Water Well Contractors)
Forbes-Bldg. 740
Topeka, Kansas 66620

1 Location of well:	County Chase	Township name NW SW NW	Fraction 1	Section number 225	Range number 6E
Distance and direction from nearest town or city: 2E, 3/4N of WONSEVU			3 Owner of well: Cotton Rodgers Address: Cedar Point KS RR 66843		
Locate with "X" in section below: 			4 Well depth: 96 ft. Date of completion 4/4 1976 Well diameter 10 in.		
2 Type and color of material			5 <input checked="" type="checkbox"/> Cable tool <input type="checkbox"/> Rotary <input type="checkbox"/> Driven <input type="checkbox"/> Dug <input type="checkbox"/> Hollow rod <input type="checkbox"/> Jetted <input type="checkbox"/> Bored <input type="checkbox"/> Reverse rotary		
			6 Use: <input checked="" type="checkbox"/> Domestic <input type="checkbox"/> Public supply <input type="checkbox"/> Industry <input type="checkbox"/> Irrigation <input type="checkbox"/> Air conditioning <input type="checkbox"/> Commercial <input type="checkbox"/> Test well <input type="checkbox"/>		
			7 Casing: Material PVC Height: above/below Threaded <input type="checkbox"/> Welded <input type="checkbox"/> Surface 24 in. Diam. 8 in. to 96 ft. depth Drive shoe? <input type="checkbox"/> Yes <input checked="" type="checkbox"/> No		
			8 Screen: Manufacturer Shopp Perforated Type Slot + PVC Dia. 8" Slot gauze 18x6" Length 67' Set between 24 ft. and 91 ft. Fittings: Gravel pack <input type="checkbox"/> Yes <input checked="" type="checkbox"/> No Size range of material		
From To CH Red Brn 0 4 Lime & Shale Green Gray 4 35 Lime soft with shale partings 35 45 Shale Gray Silty 45 47 Lime Hard 47 60 Shale Lt Gray 50 58 Lime Hard Gray Chert Nodules 58 65 Lime & Shale Gray some Chert 65 80 Lime & Shale Bryozoid stems & shells 80 84 Lime & shale Med Dense 84 96 Monc H2O 58-84 WT 33.6 4/4/76			9 Static water level: 33.6 ft. below land surface Date 4/5/76		
			10 Pumping level below land surfaces: ___ ft. after ___ hrs. pumping ___ g.p.m. ___ ft. after ___ hrs. pumping ___ g.p.m. Estimated maximum yield 4-5 g.p.m.		
			11 Water sample submitted: <input type="checkbox"/> Yes <input checked="" type="checkbox"/> No Date		
			12 Well head completion: <input checked="" type="checkbox"/> Pitless adapter <input type="checkbox"/> Inches above grade		
			13 Well grouted? <input checked="" type="checkbox"/> Yes <input type="checkbox"/> No <input checked="" type="checkbox"/> Neat cement <input type="checkbox"/> Bentonite <input type="checkbox"/> Depth: From 3 ft. to 20 ft.		
			14 Nearest source of possible contamination: ft. 100 Direction Southwest Type Septic Well disinfected upon completion? <input checked="" type="checkbox"/> Yes <input type="checkbox"/> No		
			15 Pump: <input checked="" type="checkbox"/> Not installed Manufacturer's name Model number HP Volts Length of drop pipe ft. capacity g.p.m. Type: <input type="checkbox"/> Submersible <input type="checkbox"/> Turbine <input type="checkbox"/> Jet <input type="checkbox"/> Reciprocating <input type="checkbox"/> Centrifugal <input type="checkbox"/> Other		
16 Remarks: elevation Located on upland Flat Topography: <input checked="" type="checkbox"/> Hill <input type="checkbox"/> Slope <input checked="" type="checkbox"/> Upland <input type="checkbox"/> Valley			17 Water well contractor's certification: This well was drilled under my jurisdiction and this report is true to the best of my knowledge and belief. McNee Drilling 203 Business name License No. Address Cottonwood Falls KS Signed [Signature] Date 4/20 1976 Authorized representative		

Forward the white, blue and pink copies to the Kansas State Dept. Of Health.

Form WWC-5