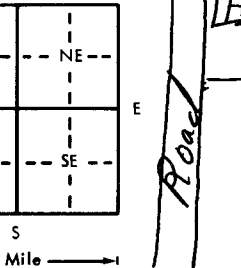
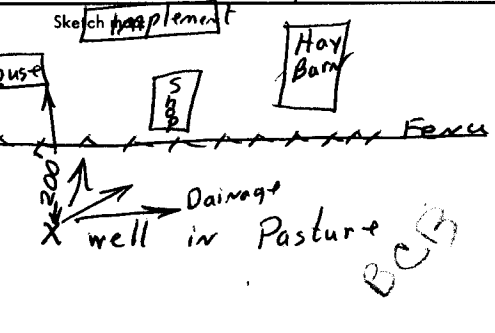


X Location of well:	County <b>Chase</b>	Fraction <b>NW 1/4 SW 1/4 NW 1/4</b>	Section number <b>30</b>	Township number T <b>22</b> S R	Range number <b>7 E</b>
X Distance and direction from nearest town or city: <b>7 mile South and 1/4 mile East of CLEMENTS</b> Street address of well location if in city: <b>Ruler Measurement from Center to Center</b>			3. Owner of well: <b>Harold Odle</b> R.R. or street: City, state, zip code: <b>Cedar Point, Kan</b>		
4. Locate with "X" in section below: <div style="text-align: center;"></div>			<div style="text-align: center;"></div>		
5. Type and color of material			From	To	
Top Soil			0	5	
LIME Broken - Yel			5	13	
LIME - Yel			13	21	
Shale - Gray			21	39	
LIME - Yel			39	46	
Shale - Gray			46	64	
LIME - Gray			64	65	
Shale - Gray			65	75	
Red Rock - Red			75	78	
LIME - Gray Abrasive			78	82	
Shale - Lite Gray			82	95	
LIME - Gray Abrasive			95	101	
(Use a second sheet if needed)					
18. Elevation:	19. Remarks: <b>Concrete slab 4'x4'x4" thick to be installed by customer</b>  <b>X Harold Odle</b>		20. Water well contractor's certification: This well was drilled under my jurisdiction and this report is true to the best of my knowledge and belief. <b>Zinn Water Well Drilling 218</b> Business name License No. Address <b>Lost Springs, Kan</b> Signed <b>Joseph A. Zinn</b> Date <b>7-5-76</b> Authorized representative		