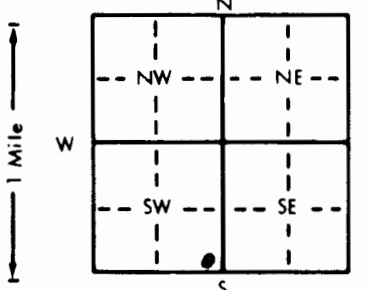


1 LOCATION OF WATER WELL: Fraction SE 1/4 SE 1/4 SW 1/4 Section Number 17 Township Number T 23 S Range Number R 1 EW

Distance and direction from nearest town or city street address of well if located within city?
First & Main St., Newton, Ks. 67114

2 WATER WELL OWNER: Cavette Dake/The Corner
 RR#, St. Address, Box # : 1318 N. Main
 City, State, ZIP Code : Newton, Ks. 67114
 Board of Agriculture, Division of Water Resources
 Application Number:

3 LOCATE WELL'S LOCATION WITH AN "X" IN SECTION BOX:

 4 DEPTH OF COMPLETED WELL: 10' ft. ELEVATION:
 Depth(s) Groundwater Encountered 1. 1 ft. 2. 1 ft. 3. 1 ft.
 WELL'S STATIC WATER LEVEL 1 ft. below land surface measured on mo/day/yr 1
 Pump test data: Well water was 1 ft. after 1 hours pumping 1 gpm
 Est. Yield 1 gpm; Well water was 1 ft. after 1 hours pumping 1 gpm
 Bore Hole Diameter: 8 1/2" in. to 10' ft., and 1 in. to 1 ft.
 WELL WATER TO BE USED AS:
 5 Public water supply 8 Air conditioning 11 Injection well
 1 Domestic 3 Feedlot 6 Oil field water supply 9 Dewatering
 2 Irrigation 4 Industrial 7 Lawn and garden only 10 Monitoring well SUE-Obs Well
 Was a chemical/bacteriological sample submitted to Department? Yes No; If yes, mo/day/yr sample was submitted
 Water Well Disinfected? Yes No

5 TYPE OF BLANK CASING USED:
 1 Steel 3 RMP (SR) 5 Wrought iron 8 Concrete tile CASING JOINTS: Glued Clamped
2 PVC 4 ABS 6 Asbestos-Cement 9 Other (specify below) Welded 1
 Blank casing diameter 2.375 in. to 3' ft., Dia 1 in. to 1 ft., Dia 1 in. to SDR 13 ft.
 Casing height above land surface Flush Mt. in., weight 1 lbs./ft. Wall thickness or gauge No. Sch. 40

TYPE OF SCREEN OR PERFORATION MATERIAL:
 1 Steel 3 Stainless steel 5 Fiberglass 8 RMP (SR) 10 Asbestos-cement
 2 Brass 4 Galvanized steel 6 Concrete tile 9 ABS 11 Other (specify) 12
 SCREEN OR PERFORATION OPENINGS ARE:
 1 Continuous slot 3 Mill slot 5 Gauzed wrapped 8 Saw cut 11 None (open hole)
 2 Louvered shutter 4 Key punched 7 Torch cut 9 Drilled holes 10 Other (specify) 12

SCREEN-PERFORATED INTERVALS: From 7' ft. to 3' ft., From 1 ft. to 1 ft.
 GRAVEL PACK INTERVALS: From 10' ft. to 2 1/2' ft., From 1 ft. to 1 ft.

6 GROUT MATERIAL: 1 Neat cement 3 Cement grout 3 Bentonite 4 Other
 Grout Intervals: From 2 1/2' ft. to 2' ft., From 2' ft. to 0' ft., From 1 ft. to 1 ft.
 What is the nearest source of possible contamination:
 1 Septic tank 4 Lateral lines 7 Pit privy 11 Fuel storage 14 Abandoned water well
 2 Sewer lines 5 Cess pool 8 Sewage lagoon 12 Fertilizer storage 15 Oil well/Gas well
 3 Watertight sewer lines 6 Seepage pit 9 Feedyard 13 Insecticide storage 16 Other (specify below)
 Direction from well? East
 How many feet? 15'

FROM	TO	LITHOLOGIC LOG	FROM	TO	PLUGGING INTERVALS
0	.50	Asphalt			
.50	4.75	Dk brn-gray brn clay, firm, faint odor, moist, oxides.			
4.75	10	Greenish gray mottled clay w/ caliche, moist, no odor.			

OK'd by D. Taylor

7 CONTRACTOR'S OR LANDOWNER'S CERTIFICATION: This water well was (1) constructed (2) reconstructed, or (3) plugged under my jurisdiction and was completed on (mo/day/year) 9-28-95 and this record is true to the best of my knowledge and belief. Kansas Water Well Contractor's License No. 539 This Water Well Record was completed on (mo/day/yr) 10-10-95 under the business name of JB Environmental Drilling by (signature) James Beck