


1	LOCATION OF WATER WELL: <b>Harvey</b>	FRACTION <b>SW 1/4 SE 1/4 SE 1/4</b>	Section Number <b>9</b>	Township Number <b>T 23 S</b>	Range Number <b>R 1E EW</b>
---	--	---	----------------------------	----------------------------------	--------------------------------

Distance and direction from nearest town or city street address of well if located within city?  
**1410 E. 12th Newton, Kansas**

2 WATER WELL OWNER: **WHITEWING Construction**  
 RR#, ST. ADDRESS, BOX #: **1410 E. 12th**  
 CITY, STATE, ZIP CODE: **Newton, Kansas**

Board of Agriculture, Division of Water Resource  
Application Number:

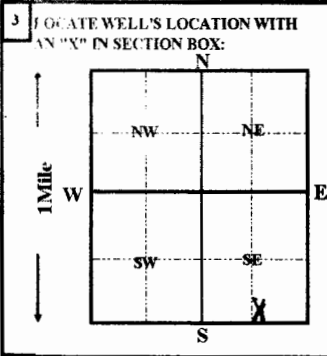

4 DEPTH OF COMPLETED WELL **80** ft. ELEVATION:

Depth(s) groundwater Encountered 1 ft. 2 ft. 3 ft.

WELL'S STATIC WATER LEVEL **10** FT. BELOW LAND SURFACE MEASURED ON **10/12/1995**

Pump test data: Well water was ft. after hours pumping gpm

Est. Yield gpm: Well water was ft. after hours pumping gpm

Bore Hole Diameter **12** in. to **80** ft. and in. to ft.

WELL WATER TO BE USED AS:

1 Domestic	3 Feedlot	6 Oil field water supply	8 Air conditioning	11 Injection well
2 Irrigation	4 Industrial	7 Lawn and garden only	9 Dewatering	12 Other (Specify below)
			10 Monitoring well	

Was a chemical/bacteriological sample submitted to Department? Yes No **X**; If yes, mo/day/yr sample was submitted Water Well Disinfected? Yes **X** No

5 TYPE OF CASING USED:

1 Steel	3 RMP (SR)	5 Wrought iron	8 Concrete tile	CASING JOINTS:	Glued <b>X</b> Clamped
2 PVC	4 ABS	6 Asbestos-Cement	9 Other (Specify below)		Welded
		7 Fiberglass	<b>SDR-26</b>		Threaded

Blank casing Diameter **5** in. to **80** ft., Dia in. to ft., Dia in. to ft.

Casing height above land surface **12** in., weight **2.35** lbs./ft. Wall thickness or gauge No. **.214**

TYPE OF SCREEN OR PERFORATION MATERIAL:

1 Steel	3 Stainless Steel	5 Fiberglass	8 RMP (SR)	11 other (specify)
2 Brass	4 Galvanized steel	6 Concrete tile	9 ABS	12 None used (open hole)

SCREEN OR PERFORATION OPENING ARE:

1 Continuous slot	3 Mill slot	5 Gauzed wrapped	8 Saw cut	11 None (open hole)
2 Louvered shutter	4 Key punched	6 Wire wrapped	9 Drilled holes	
		7 Torch cut	10 Other (specify)	

SCREEN-PERFORATION INTERVALS: from **24** ft. to **80** ft., From ft. to ft.

GRAVEL PACK INTERVALS: from **24** ft. to **80** ft., From ft. to ft.

6 GROUT MATERIAL: 1 Neat cement 2 Cement grout 3 Bentonite 4 Other

Grout intervals: From **4** ft. to **24** ft. From ft. to ft. From ft. to ft.

What is the nearest source of possible contamination:

1 Septic tank	4 Lateral lines	7 Pit privy	10 Livestock pens	14 Abandon water well
2 Sewer lines	5 Cess pool	8 Sewage lagoon	11 Fuel storage	15 Oil well/Gas well
3 Watertight sewer lines	6 Seepage pit	9 Feedyard	12 Fertilizer storage	16 Other (specify below)
			13 Insecticide storage	<b>None Apparent</b>

Direction from well? How many feet?

FROM	TO	LITHOLOGIC LOG	FROM	TO	PLUGGING INTERVALS
0	4	topsoil			
4	12	clay			
12	13	sand			
13	80	shale			

7 CONTRACTOR'S OR LANDOWNER'S CERTIFICATION: This water well was (1) constructed, (2) reconstructed, or (3) plugged under my jurisdiction and was completed on (mo/day/year) **10/12/1995** and this record is true to the best of my knowledge and belief. Kansas Water Well Contractor's License No. **236** This Water Well Record was completed on (mo/day/yr) **10/13/95**

Under the business name of **Harp Well & Pump Service, Inc.** by (signature) *Jane Frederick*