


1 LOCATION OF WATER WELL: Fraction Mc 1/4 Se 1/4 Se 1/4 Section Number 13 Township Number T 23 S Range Number R 1 E  
 County: Harvey

Distance and direction from nearest town or city street address of well if located within city?  
In City Newton 700 Normandy

2 WATER WELL OWNER: Don Bonewitz  
 RR#, St. Address, Box #: 700 Normandy  
 City, State, ZIP Code: Newton, KS, 67114  
 Board of Agriculture, Division of Water Resources  
 Application Number:

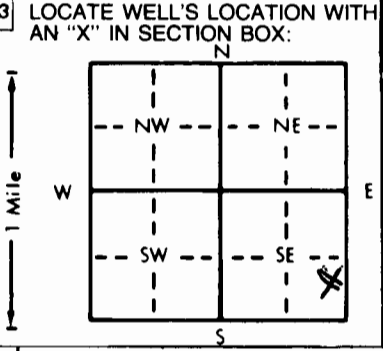

4 DEPTH OF COMPLETED WELL: 62 ft. ELEVATION: ..... ft.  
 Depth(s) Groundwater Encountered 1. 16 ft. 2. 30 ft. 3. .... ft.  
 WELL'S STATIC WATER LEVEL 16 ft. below land surface measured on mo/day/yr 10-13-95  
 Pump test data: Well water was ..... ft. after ..... hours pumping ..... gpm  
 Est. Yield 20 gpm Well water was ..... ft. after ..... hours pumping ..... gpm  
 Bore Hole Diameter: 9 in. to 62 ft., and ..... in. to ..... ft.  
 WELL WATER TO BE USED AS:  
 5 Public water supply 8 Air conditioning 11 Injection well  
 1 Domestic 3 Feedlot 6 Oil field water supply 9 Dewatering 12 Other (Specify below)  
 2 Irrigation 4 Industrial 7 Lawn and garden only 10 Monitoring well .....  
 Was a chemical/bacteriological sample submitted to Department? Yes ..... No X ..... If yes, mo/day/yr sample was submitted  
 Water Well Disinfected? Yes X No

5 TYPE OF BLANK CASING USED:  
 1 Steel 3 RMP (SR) 5 Wrought iron 8 Concrete tile CASING JOINTS: Glued X Clamped .....  
 2 PVC 4 ABS 6 Asbestos-Cement 9 Other (specify below) Welded .....  
 7 Fiberglass Threaded .....  
 Blank casing diameter 5 in. to 30 ft., Dia 5 in. to 62 ft., Dia ..... in. to ..... ft.  
 Casing height above land surface 12 in., weight CLASP 100 lbs./ft. Wall thickness or gauge No. 219  
 TYPE OF SCREEN OR PERFORATION MATERIAL:  
 1 Steel 3 Stainless steel 5 Fiberglass 7 PVC 10 Asbestos-cement  
 2 Brass 4 Galvanized steel 6 Concrete tile 8 RMP (SR) 11 Other (specify) .....  
 9 ABS 12 None used (open hole)  
 SCREEN OR PERFORATION OPENINGS ARE:  
 5 Gauzed wrapped 8 Saw cut 11 None (open hole)  
 1 Continuous slot 3 Mill slot 6 Wire wrapped 9 Drilled holes  
 2 Louvered shutter 4 Key punched 7 Torch cut 10 Other (specify) .....  
 SCREEN-PERFORATED INTERVALS: From 30 ft. to 40 ft., From ..... ft. to ..... ft.  
 From ..... ft. to ..... ft., From ..... ft. to ..... ft.  
 GRAVEL PACK INTERVALS: From 20 ft. to 62 ft., From ..... ft. to ..... ft.  
 From ..... ft. to ..... ft., From ..... ft. to ..... ft.

6 GROUT MATERIAL: 1 Neat cement 2 Cement grout 3 Bentonite 4 Other .....  
 Grout Intervals: From 0 ft. to 20 ft., From ..... ft. to ..... ft., From ..... ft. to ..... ft.  
 What is the nearest source of possible contamination:  
 1 Septic tank 4 Lateral lines 7 Pit privy 10 Livestock pens 14 Abandoned water well  
 2 Sewer lines 5 Cess pool 8 Sewage lagoon 11 Fuel storage 15 Oil well/Gas well  
 3 Watertight sewer lines 6 Seepage pit 9 Feedyard 12 Fertilizer storage 16 Other (specify below)  
 13 Insecticide storage .....  
 Direction from well? S How many feet? 40 +

FROM	TO	LITHOLOGIC LOG	FROM	TO	PLUGGING INTERVALS
0	25	Clay			
25	45	Clay + Sand			
45	62	Blue Shale			

7 CONTRACTOR'S OR LANDOWNER'S CERTIFICATION: This water well was (1) constructed, (2) reconstructed, or (3) plugged under my jurisdiction and was completed on (mo/day/year) 11-13-95 and this record is true to the best of my knowledge and belief. Kansas Water Well Contractor's License No. 120 This Water Well Record was completed on (mo/day/yr) 10-6-95 under the business name of Backhus Drilling by (signature) Paul H. Backhus

OFFICE USE ONLY  
T  
R  
EW  
SEC.  
1/4  
1/4  
1/4