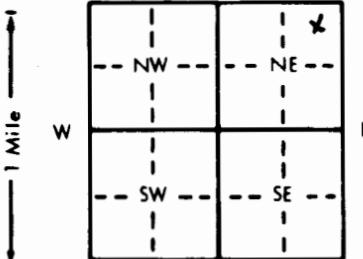


1 LOCATION OF WATER WELL:		Fraction		Section Number		Township Number		Range Number			
County: <u>Harvey</u>		<u>NE 1/4 NE 1/4 NE 1/4</u>		<u>21</u>		T <u>23</u> S		R <u>1</u> <u>EW</u>			
Distance and direction from nearest town or city street address of well if located within city? <u>1525 E. 1st, Newton</u>											
2 WATER WELL OWNER: <u>Charles Hill</u> RR#, St. Address, Box #: <u>409 Sherman</u> City, State, ZIP Code: <u>Newton, KS 67114</u> Board of Agriculture, Division of Water Resources Application Number:											
3 LOCATE WELL'S LOCATION WITH AN "X" IN SECTION BOX:				4 DEPTH OF COMPLETED WELL: <u>15</u> ft. ELEVATION: <u>1466.42</u>							
				Depth(s) Groundwater Encountered 1. <u>10</u> ft. 2. <u>10</u> ft. 3. <u>10</u> ft.							
				WELL'S STATIC WATER LEVEL <u>12.70</u> ft. below land surface measured on mo/day/yr <u>2-16-96</u>							
				Pump test data: Well water was <u>N/A</u> ft. after <u> </u> hours pumping <u> </u> gpm							
				Est. Yield <u> </u> gpm: Well water was <u>N/A</u> ft. after <u> </u> hours pumping <u> </u> gpm							
Bore Hole Diameter: <u>8</u> in. to <u>15</u> in. and <u> </u> in. to <u> </u> in.				WELL WATER TO BE USED AS:							
1 Domestic				3 Feedlot		6 Oil field water supply		9 Dewatering		11 Injection well	
2 Irrigation				4 Industrial		7 Lawn and garden only		10 Monitoring well		12 Other (Specify below)	
Was a chemical/bacteriological sample submitted to Department? Yes <u> </u> No <u> </u>				If yes, mo/day/yr sample was submitted <u> </u>							
Water Well Disinfected? Yes <u> </u> No <u> </u>											
5 TYPE OF BLANK CASING USED:											
1 Steel											
2 PVC											
3 RMP (SR)											
4 ABS											
5 Wrought iron											
6 Asbestos-Cement											
7 Fiberglass											
8 Concrete tile											
9 Other (specify below)											
CASING JOINTS: Glued <u> </u> Clamped <u> </u>											
Welded <u> </u>											
Threaded <u>X</u>											
Blank casing diameter <u>2</u> in. to <u>5</u> ft. Dia. <u> </u> in. to <u> </u> ft. Dia. <u> </u> in. to <u> </u> ft.											
Casing height above land surface <u>Flush</u> in. weight <u> </u> lbs./ft. Wall thickness or gauge No. <u>40</u>											
TYPE OF SCREEN OR PERFORATION MATERIAL:											
1 Steel											
2 Brass											
3 Stainless steel											
4 Galvanized steel											
5 Fiberglass											
6 Concrete tile											
8 RMP (SR)											
9 ABS											
10 Asbestos-cement											
11 Other (specify)											
12 None used (open hole)											
SCREEN OR PERFORATION OPENINGS ARE:											
1 Continuous slot											
2 Louvered shutter											
3 Mill slot											
4 Key punched											
5 Gauzed wrapped											
6 Wire wrapped											
7 Torch cut											
8 Saw cut											
9 Drilled holes											
10 Other (specify)											
11 None (open hole)											
SCREEN-PERFORATED INTERVALS:											
From <u>5</u> ft. to <u>15</u> ft. From <u> </u> ft. to <u> </u> ft. From <u> </u> ft. to <u> </u> ft.											
GRAVEL PACK INTERVALS:											
From <u>3</u> ft. to <u>15</u> ft. From <u> </u> ft. to <u> </u> ft. From <u> </u> ft. to <u> </u> ft.											
6 GROUT MATERIAL:											
1 Neat cement											
2 Cement grout											
3 Bentonite											
4 Other											
Grout Intervals: From <u>0</u> ft. to <u>1</u> ft. From <u>1</u> ft. to <u>3</u> ft. From <u> </u> ft. to <u> </u> ft.											
What is the nearest source of possible contamination:											
1 Septic tank											
2 Sewer lines											
3 Watertight sewer lines											
4 Lateral lines											
5 Cess pool											
6 Seepage pit											
7 Pit privy											
8 Sewage lagoon											
9 Feedyard											
10 Livestock pens											
11 Fuel storage											
12 Fertilizer storage											
13 Insecticide storage											
14 Abandoned water well											
15 Oil well/Gas well											
16 Other (specify below)											
Direction from well? <u>E-NE</u>											
How many feet? <u>115</u>											
FROM TO LITHOLOGIC LOG FROM TO PLUGGING INTERVALS											
<u>0</u> <u>3</u> <u>Silty clay top soil</u> <u> </u> <u> </u>											
<u>3</u> <u>6</u> <u>gray clay</u> <u> </u> <u> </u>											
<u>6</u> <u>9.5</u> <u>Clay w/ SILT</u> <u> </u> <u> </u>											
<u>9.5</u> <u>15</u> <u>Weathered Shale</u> <u> </u> <u> </u>											
7 CONTRACTOR'S OR LANDOWNER'S CERTIFICATION: This water well was <u>(1)</u> constructed, <u>(2)</u> reconstructed, or <u>(3)</u> plugged under my jurisdiction and was completed on (mo/day/year) <u>2-14-96</u> and this record is true to the best of my knowledge and belief. Kansas Water Well Contractor's License No. <u>571</u> This Water Well Record was completed on (mo/day/yr) <u>3-7-96</u> under the business name of <u>BDAT Environmental, Inc.</u> by (signature) <u>[Signature]</u>											
INSTRUCTIONS: Use typewriter or ball point pen. PLEASE PRESS FIRMLY and PRINT clearly. Please fill in blanks, underline or circle the correct answers. Send top three copies to Kansas Department of Health and Environment, Bureau of Water, Topeka, Kansas 66620-0001. Telephone: 913-296-5545. Send one to WATER WELL OWNER and retain one for your records.											