


1 LOCATION OF WATER WELL: Fraction NE 1/4 NE 1/4 NE 1/4 Section Number 21 Township Number T 23 S Range Number R 1 E  
 County: Harvey

Distance and direction from nearest town or city street address of well if located within city?

1609 E. 1st, Newton

2 WATER WELL OWNER: Charles Hill  
 RR#, St. Address, Box #: 409 Sherman  
 City, State, ZIP Code: Newton, KS 67114  
 Board of Agriculture, Division of Water Resources  
 Application Number:

3 LOCATE WELL'S LOCATION WITH AN "X" IN SECTION BOX:

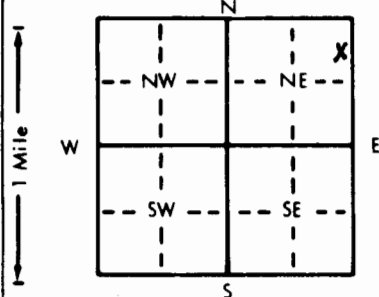

4 DEPTH OF COMPLETED WELL: 15.5 ft. ELEVATION: 1465.90

Depth(s) Groundwater Encountered 1. 10.5 ft. 2. ft. 3. ft.

WELL'S STATIC WATER LEVEL 10.22 ft. below land surface measured on mo/day/yr 2-16-96

Pump test data: Well water was ft. after hours pumping gpm

Est. Yield gpm: Well water was N/A ft. after hours pumping gpm

Bore Hole Diameter 8 in. to 16 ft., and in. to ft.

WELL WATER TO BE USED AS: 5 Public water supply 8 Air conditioning 11 Injection well

1 Domestic 3 Feedlot 6 Oil field water supply 9 Dewatering 12 Other (Specify below)

2 Irrigation 4 Industrial 7 Lawn and garden only Monitoring well MW-9

Was a chemical/bacteriological sample submitted to Department? Yes No ✓; If yes, mo/day/yr sample was submitted

Water Well Disinfected? Yes No

5 TYPE OF BLANK CASING USED: 5 Wrought iron 8 Concrete tile CASING JOINTS: Glued Clamped

1 Steel 3 RMP (SR) 6 Asbestos-Cement 9 Other (specify below) Welded

OPVC 4 ABS 7 Fiberglass Threaded X

Blank casing diameter 2 in. to 5.5 ft. Dia. in. to ft. Dia. in. to ft.

Casing height above land surface Flush in. weight lbs./ft. Wall thickness or gauge No. 40

TYPE OF SCREEN OR PERFORATION MATERIAL: OPVC 10 Asbestos-cement

1 Steel 3 Stainless steel 5 Fiberglass 8 RMP (SR) 11 Other (specify)

2 Brass 4 Galvanized steel 6 Concrete tile 9 ABS 12 None used (open hole)

SCREEN OR PERFORATION OPENINGS ARE: 5 Gauzed wrapped 8 Saw cut 11 None (open hole)

1 Continuous slot 3 Mill slot 6 Wire wrapped 9 Drilled holes

2 Louvered shutter 4 Key punched 7 Torch cut 10 Other (specify)

SCREEN-PERFORATED INTERVALS: From 5.5 ft. to 15.5 ft. From ft. to ft.

From ft. to ft. From ft. to ft.

GRAVEL PACK INTERVALS: From 3 ft. to 16 ft. From ft. to ft.

From ft. to ft. From ft. to ft.

6 GROUT MATERIAL: 1 Neat cement 2 Cement grout 3 Bentonite 4 Other

Grout Intervals: From 0 ft. to 1 ft. From 1 ft. to 3 ft. From ft. to ft.

What is the nearest source of possible contamination: 10 Livestock pens 14 Abandoned water well

1 Septic tank 4 Lateral lines 7 Pit privy 11 Fuel storage 15 Oil well/Gas well

2 Sewer lines 5 Cess pool 8 Sewage lagoon 12 Fertilizer storage 16 Other (specify below)

3 Watertight sewer lines 6 Seepage pit 9 Feedyard 13 Insecticide storage

Direction from well? N How many feet? 175

FROM TO LITHOLOGIC LOG FROM TO PLUGGING INTERVALS

0 4 Gravel with clay + concrete frags FILL

4 7.5 Clay with silt

7.5 14 Weathered shale

14 16 Shale

7 CONTRACTOR'S OR LANDOWNER'S CERTIFICATION: This water well was 1 constructed, (2) reconstructed, or (3) plugged under my jurisdiction and was completed on (mo/day/year) 11-7-95 and this record is true to the best of my knowledge and belief. Kansas

Water Well Contractor's License No. 571 This Water Well Record was completed on (mo/day/yr) 3-7-96

under the business name of BDAT Environmental, Inc. by (signature) [Signature]

INSTRUCTIONS: Use typewriter or ball point pen. PLEASE PRESS FIRMLY and PRINT clearly. Please fill in blanks, underline or circle the correct answers. Send top three copies to Kansas Department of Health and Environment, Bureau of Water, Topeka, Kansas 66620-0001. Telephone: 913-296-5545. Send one to WATER WELL OWNER and retain one for your records.