


MW-1 2311048

1 LOCATION OF WATER WELL: Fraction SW 1/4 SE 1/4 SW 1/4 Section Number 17 Township Number T 23 S Range Number R 1 E/W

Distance and direction from nearest town or city street address of well if located within city? N & E of 300 W. 1st St.

2 WATER WELL OWNER: RR#, St. Address, Box #: KG & E 300 W. 1st St. City, State, ZIP Code: Newton KS 67144 Board of Agriculture, Division of Water Resources Application Number:

3 LOCATE WELL'S LOCATION WITH AN "X" IN SECTION BOX:

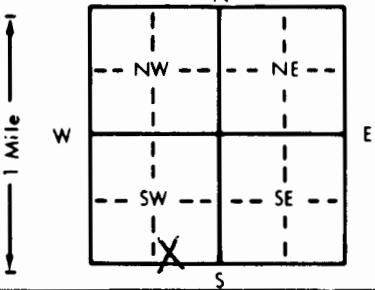

4 DEPTH OF COMPLETED WELL: 20 ft. ELEVATION: 1437.82

Depth(s) Groundwater Encountered 1 11 ft. 2 ft. 3 ft. WELL'S STATIC WATER LEVEL 9.5 ft. below land surface measured on mo/day/yr 11/13/95 Pump test data: Well water was ft. after hours pumping gpm Est. Yield gpm: Well water was ft. after hours pumping gpm Bore Hole Diameter 8 in. to ft., and in. to ft. WELL WATER TO BE USED AS: 5 Public water supply 8 Air conditioning 11 Injection well 1 Domestic 3 Feedlot 6 Oil field water supply 9 Dewatering 12 Other (Specify below) 2 Irrigation 4 Industrial 7 Lawn and garden only 10 Monitoring well Was a chemical/bacteriological sample submitted to Department? Yes No X; If yes, mo/day/yr sample was submitted Water Well Disinfected? Yes No X

5 TYPE OF BLANK CASING USED: 1 Steel 3 RMP (SR) 5 Wrought iron 8 Concrete tile CASING JOINTS: Glued Clamped 2 PVC 4 ABS 7 Fiberglass 9 Other (specify below) Welded 10 Asbestos-Cement Threaded Flush

Blank casing diameter 2 in. to ft., Dia in. to ft., Dia in. to ft. Casing height above land surface Flush in., weight .703 lbs./ft. Wall thickness or gauge No. Sch 40

TYPE OF SCREEN OR PERFORATION MATERIAL: 1 Steel 3 Stainless steel 5 Fiberglass 8 RMP (SR) 10 Asbestos-cement 2 Brass 4 Galvanized steel 6 Concrete tile 9 ABS 11 Other (specify) 12 None used (open hole)

SCREEN OR PERFORATION OPENINGS ARE: 1 Continuous slot 5 Mill slot 6 Wire wrapped 8 Saw cut 11 None (open hole) 2 Louvered shutter 4 Key punched 7 Torch cut 9 Drilled holes 10 Other (specify)

SCREEN-PERFORATED INTERVALS: From 9.5 ft. to 20 ft., From ft. to ft. From ft. to ft. From ft. to ft.

GRAVEL PACK INTERVALS: From 7.5 ft. to 20 ft., From ft. to ft. From ft. to ft.

6 GROUT MATERIAL: 1 Neat cement 2 Cement grout 3 Bentonite 4 Other

Grout Intervals: From 7.5 ft. to 1.0 ft., From ft. to ft., From ft. to ft.

What is the nearest source of possible contamination: 1 Septic tank 4 Lateral lines 7 Pit privy 10 Livestock pens 14 Abandoned water well 2 Sewer lines 5 Cess pool 8 Sewage lagoon 11 Fuel storage 15 Oil well/Gas well 3 Watertight sewer lines 6 Seepage pit 9 Feedyard 12 Fertilizer storage 16 Other (specify below) 13 Insecticide storage FMGP, former

Direction from well? W How many feet? 70'

FROM TO LITHOLOGIC LOG FROM TO PLUGGING INTERVALS

Table with 4 columns: FROM, TO, LITHOLOGIC LOG, FROM, TO, PLUGGING INTERVALS. Rows contain depth intervals and lithological descriptions: 0.0-11.0 Silty Clay, some sand; 11.0-13.0 Clayey sand; 13.0-18.0 Sandy clay; 18.0-19.5 Clayey sand; 19.5-20 Shale.

GSI sent Don Taylor a request for an extension for filing on 12-12-95 by Allison Irwin

7 CONTRACTOR'S OR LANDOWNER'S CERTIFICATION: This water well was (1) constructed (2) reconstructed, or (3) plugged under my jurisdiction and was completed on (mo/day/year) 11-18-95 and this record is true to the best of my knowledge and belief. Kansas

Water Well Contractor's License No. 531 This Water Well Record was completed on (mo/day/yr) 3-12-96 under the business name of GSI by (signature) Allison Irwin