


MW-2 2311048

1 LOCATION OF WATER WELL: County: Harvey Fraction: SW 1/4 SE 1/4 SW 1/4 Section Number: 17 Township Number: T 23 S Range Number: R 1 E/W

Distance and direction from nearest town or city street address of well if located within city?
300 W. 1st St.

2 WATER WELL OWNER: RR#, St. Address, Box #: KGE 300 W. 1st St. Newton KS 67144 Board of Agriculture, Division of Water Resources
City, State, ZIP Code: Newton KS 67144 Application Number:

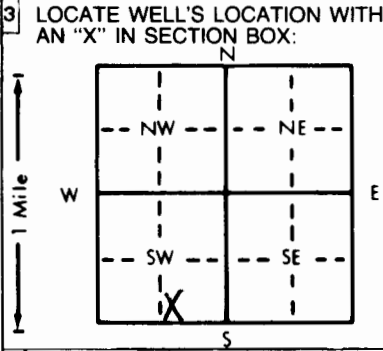

4 DEPTH OF COMPLETED WELL: 21.5 ft. ELEVATION: 1436.01

Depth(s) Groundwater Encountered 1. 10 ft. 2. _____ ft. 3. _____ ft.

WELL'S STATIC WATER LEVEL: N/A ft. below land surface measured on mo/day/yr N/A

Pump test data: Well water was _____ ft. after _____ hours pumping _____ gpm

Est. Yield _____ gpm Well water was _____ ft. after _____ hours pumping _____ gpm

Bore Hole Diameter: 8 in. to _____ ft., and _____ in. to _____ ft.

WELL WATER TO BE USED AS:

5 Public water supply	8 Air conditioning	11 Injection well
1 Domestic	3 Feedlot	6 Oil field water supply
2 Irrigation	4 Industrial	7 Lawn and garden only
		<u>0 Monitoring well</u>
		12 Other (Specify below)

Was a chemical/bacteriological sample submitted to Department? Yes _____ No X; If yes, mo/day/yr sample was submitted _____

Water Well Disinfected? Yes _____ No X

5 TYPE OF BLANK CASING USED:

1 Steel	3 RMP (SR)	5 Wrought iron	8 Concrete tile	CASING JOINTS: Glued _____ Clamped _____
<u>2 PVC</u>	4 ABS	6 Asbestos-Cement	9 Other (specify below)	Welded _____
		7 Fiberglass		<u>Threaded Flush</u>

Blank casing diameter: 2 in. to _____ ft., Dia _____ in. to _____ ft., Dia _____ in. to _____ ft.

Casing height above land surface: Flush in., weight 1703 lbs./ft. Wall thickness or gauge No. Sch 40

TYPE OF SCREEN OR PERFORATION MATERIAL:

1 Steel	3 Stainless steel	5 Fiberglass	8 RMP (SR)	10 Asbestos-cement
2 Brass	4 Galvanized steel	6 Concrete tile	9 ABS	11 Other (specify)
				12 None used (open hole)

SCREEN OR PERFORATION OPENINGS ARE:

1 Continuous slot	<u>3 Mill slot</u>	5 Gauzed wrapped	8 Saw cut	11 None (open hole)
2 Louvered shutter	4 Key punched	6 Wire wrapped	9 Drilled holes	
		7 Torch cut	10 Other (specify)	

SCREEN-PERFORATED INTERVALS: From 11 ft. to 21.5 ft., From _____ ft. to _____ ft., From _____ ft. to _____ ft.

GRAVEL PACK INTERVALS: From 9 ft. to 21.5 ft., From _____ ft. to _____ ft., From _____ ft. to _____ ft.

6 GROUT MATERIAL: 1 Neat cement 2 Cement grout 3 Bentonite 4 Other _____

Grout Intervals: From 9 ft. to 1 ft., From _____ ft. to _____ ft., From _____ ft. to _____ ft.

What is the nearest source of possible contamination:

1 Septic tank	4 Lateral lines	7 Pit privy	10 Livestock pens	14 Abandoned water well
2 Sewer lines	5 Cess pool	8 Sewage lagoon	11 Fuel storage	15 Oil well/Gas well
3 Watertight sewer lines	6 Seepage pit	9 Feedyard	12 Fertilizer storage	<u>16 Other (specify below)</u>
			13 Insecticide storage	<u>Former FMGP</u>

Direction from well? E How many feet? 150'

FROM	TO	LITHOLOGIC LOG	FROM	TO	PLUGGING INTERVALS
0.0	2.5	Clayey silt, rubble			
2.5	5.0	Silty Clay			
5.0	10.0	Clayey Silt			
10.0	13.0	Clay, trace sand			
13.0	19.5	Sandy Clay			
19.5	21.5	Shale			

GSI sent Don Taylor a request for an extension for filing on 12-12-95 by Allison Irwin

7 CONTRACTOR'S OR LANDOWNER'S CERTIFICATION: This water well was (1) constructed, (2) reconstructed, or (3) plugged under my jurisdiction and was completed on (mo/day/year) 11-18-95 and this record is true to the best of my knowledge and belief. Kansas Water Well Contractor's License No. 531 This Water Well Record was completed on (mo/day/yr) 3-12-96 under the business name of GSI by (signature) Allison Irwin