


1 LOCATION OF WATER WELL: County: Harvey Fraction: Ne 1/4 Sec 1/4 Sw 1/4 Section Number: 14 Township Number: T 23 S Range Number: R 1 E/W

Distance and direction from nearest town or city street address of well if located within city?
In City Newton 1401 Maple St.

2 WATER WELL OWNER: Marvin Wenger
 RR#, St. Address, Box #: 1401 Maple St.
 City, State, ZIP Code: Newton, Mo. 67114
 Board of Agriculture, Division of Water Resources
 Application Number:

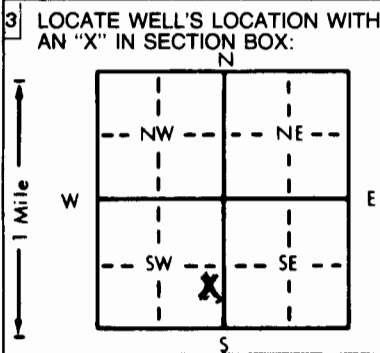

4 DEPTH OF COMPLETED WELL: 95 ft. ELEVATION:ft.
 Depth(s) Groundwater Encountered 1. 65 ft. 2.ft. 3.ft.
 WELL'S STATIC WATER LEVEL: 21 ft. below land surface measured on mo/day/yr 5-22-96
 Pump test data: Well water wasft. after hours pumping gpm
 Est. Yield 20 gpm Well water wasft. after hours pumping gpm
 Bore Hole Diameter: 9 in. to 35 ft., and 7 1/2 in. to 95 ft.
 WELL WATER TO BE USED AS:
 5 Public water supply 8 Air conditioning 11 Injection well
 1 Domestic 3 Feedlot 6 Oil field water supply 9 Dewatering 12 Other (Specify below)
 2 Irrigation 4 Industrial 7 Lawn and garden only 10 Monitoring well
 Was a chemical/bacteriological sample submitted to Department? Yes.....No.....; If yes, mo/day/yr sample was submitted
 Water Well Disinfected? Yes No

5 TYPE OF BLANK CASING USED:
 1 Steel 3 RMP (SR) 5 Wrought iron 8 Concrete tile CASING JOINTS: Glued Clamped
 2 PVC 4 ABS 6 Asbestos-Cement 9 Other (specify below) Welded
 7 Fiberglass Threaded
 Blank casing diameter 5 in. to 15 ft. Dia 5 in. to 65 ft. Dia 5 in. to 80 ft.
 Casing height above land surface: 12 in., weight Class 160 lbs./ft. Wall thickness or gauge No.
 TYPE OF SCREEN OR PERFORATION MATERIAL:
 1 Steel 3 Stainless steel 5 Fiberglass 7 PVC 10 Asbestos-cement
 2 Brass 4 Galvanized steel 6 Concrete tile 8 RMP (SR) 11 Other (specify)
 9 ABS 12 None used (open hole)
 SCREEN OR PERFORATION OPENINGS ARE:
 1 Continuous slot 3 Mill slot 5 Gauzed wrapped 8 Saw cut 11 None (open hole)
 2 Louvered shutter 4 Key punched 6 Wire wrapped 9 Drilled holes
 7 Torch cut 10 Other (specify)
 SCREEN-PERFORATED INTERVALS: From 15 ft. to 25 ft. From 50 ft. to 65 ft.
 From 20 ft. to 95 ft. Fromft. toft.
 GRAVEL PACK INTERVALS: From 15 ft. to 95 ft. Fromft. toft.
 Fromft. toft. Fromft. toft.

6 GROUT MATERIAL: 1 Neat cement 2 Cement grout 3 Bentonite 4 Other
 Grout Intervals: From 0 ft. to 15 ft. Fromft. toft. Fromft. toft.
 What is the nearest source of possible contamination:
 1 Septic tank 4 Lateral lines 7 Pit privy 10 Livestock pens 14 Abandoned water well
 2 Sewer lines 5 Cess pool 8 Sewage lagoon 11 Fuel storage 15 Oil well/Gas well
 3 Watertight sewer lines 6 Seepage pit 9 Feedyard 12 Fertilizer storage 16 Other (specify below)
 13 Insecticide storage
 Direction from well? E How many feet? 50 +

FROM	TO	LITHOLOGIC LOG	FROM	TO	PLUGGING INTERVALS
0	15	Clay			
15	24	Sand			
24	50	Blue Shale			
50	52	Broken Shale			
52	65	Blue 1'			
65	67	Broken "			
67	95	Blue & Gray Shale			

7 CONTRACTOR'S OR LANDOWNER'S CERTIFICATION: This water well was (1) constructed, (2) reconstructed, or (3) plugged under my jurisdiction and was completed on (mo/day/year) 5-22-95 and this record is true to the best of my knowledge and belief. Kansas Water Well Contractor's License No. 180 This Water Well Record was completed on (mo/day/yr) 5-22-95 under the business name of Backhus Drilling by (signature) Paul H. Backhus