


1 LOCATION OF WATER WELL: County: Harvey Fraction: SW 1/4 SW 1/4 NW 1/4 Section Number: 16 Township Number: T 23 S Range Number: R 1 EW

Distance and direction from nearest town or city street address of well if located within city?
509 E 7th St In Newton

2 WATER WELL OWNER: Harry Kasitz
RR#, St. Address, Box #: 509 E 7th St Board of Agriculture, Division of Water Resources
City, State, ZIP Code: Newton, KS 67114 Application Number:

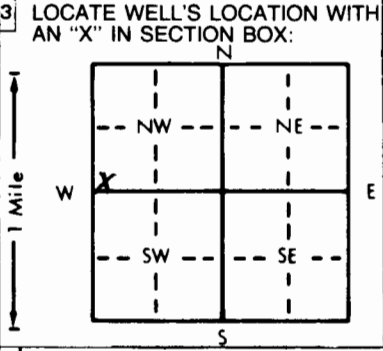

4 DEPTH OF COMPLETED WELL: 85 ft. ELEVATION: _____
Depth(s) Groundwater Encountered 1. _____ ft. 2. _____ ft. 3. _____ ft.
WELL'S STATIC WATER LEVEL: 17 ft. below land surface measured on mo/day/yr 7-18-86
Pump test data: Well water was 8.0 ft. after 1/2 hours pumping 6 gpm
Est. Yield 6 gpm: Well water was _____ ft. after _____ hours pumping _____ gpm
Bore Hole Diameter: 9 in. to 20 ft., and 5 1/2 in. to 8.5 ft.
WELL WATER TO BE USED AS:
5 Public water supply 8 Air conditioning 11 Injection well
1 Domestic 3 Feedlot 6 Oil field water supply 9 Dewatering 12 Other (Specify below)
2 Irrigation 4 Industrial 1 Lawn and garden only 10 Monitoring well
Was a chemical/bacteriological sample submitted to Department? Yes _____ No X; If yes, mo/day/yr sample was submitted _____
Water Well Disinfected? Yes No

5 TYPE OF BLANK CASING USED:
1 Steel 3 RMP (SR) 5 Wrought iron 8 Concrete tile CASING JOINTS: Glued X Clamped _____
2 PVC 4 ABS 6 Asbestos-Cement 9 Other (specify below) Welded _____
7 Fiberglass Threaded _____
Blank casing diameter 6 in. to 20 ft., Dia _____ in. to _____ ft., Dia _____ in. to _____ ft.
Casing height above land surface 12 in., weight _____ lbs./ft. Wall thickness or gauge No. 16.5
TYPE OF SCREEN OR PERFORATION MATERIAL:
1 Steel 3 Stainless steel 5 Fiberglass 8 RMP (SR) 10 Asbestos-cement 11 Other (specify) _____
2 Brass 4 Galvanized steel 6 Concrete tile 9 ABS 12 None used (open hole)
SCREEN OR PERFORATION OPENINGS ARE:
1 Continuous slot 3 Mill slot 5 Gauzed wrapped 8 Saw cut 11 None (open hole)
2 Louvered shutter 4 Key punched 6 Wire wrapped 9 Drilled holes
7 Torch cut 10 Other (specify) _____
SCREEN-PERFORATED INTERVALS: From _____ ft. to _____ ft., From _____ ft. to _____ ft.
GRAVEL PACK INTERVALS: From _____ ft. to _____ ft., From _____ ft. to _____ ft.

6 GROUT MATERIAL: 1 Neat cement 2 Cement grout 3 Bentonite 4 Other _____
Grout Intervals: From 0 ft. to 20 ft., From _____ ft. to _____ ft., From _____ ft. to _____ ft.
What is the nearest source of possible contamination:
1 Septic tank 4 Lateral lines 7 Pit privy 10 Livestock pens 14 Abandoned water well
2 Sewer lines 5 Cess pool 8 Sewage lagoon 11 Fuel storage 15 Oil well/Gas well
3 Watertight sewer lines 6 Seepage pit 9 Feedyard 12 Fertilizer storage 16 Other (specify below)
13 Insecticide storage _____
Direction from well? E How many feet? 25

FROM	TO	LITHOLOGIC LOG	FROM	TO	PLUGGING INTERVALS
0	12	Br clay			
12	85	Shale			

7 CONTRACTOR'S OR LANDOWNER'S CERTIFICATION: This water well was 1 constructed, (2) reconstructed, or (3) plugged under my jurisdiction and was completed on (mo/day/year) 7-18-86 and this record is true to the best of my knowledge and belief. Kansas Water Well Contractor's License No. 447 This Water Well Record was completed on (mo/day/yr) 7-27-86 under the business name of Miller Drilling by (signature) G Miller

INSTRUCTIONS: Use typewriter or ball point pen. PLEASE PRESS FIRMLY and PRINT clearly. Please fill in blanks, underline or circle the correct answers. Send top three copies to Kansas Department of Health and Environment, Bureau of Water, Topeka, Kansas 66620-0001. Telephone: 913-296-5545. Send one to WATER WELL OWNER and retain one for your records.