

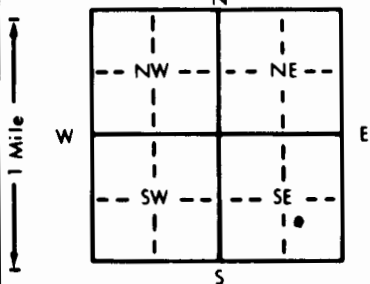
WATER WELL RECORD Form WWC-5 KSA 82a-1212

12

1 LOCATION OF WATER WELL: County: Harvey Fraction: NW 1/4 SE 1/4 SE 1/4 Section Number: 20 Township Number: T 23 S Range Number: R 1 E

Distance and direction from nearest town or city street address of well if located within city?
In town

2 WATER WELL OWNER: Phill Garrison
RR#, St. Address, Box #: 1107 S. Washington
City, State, ZIP Code: Newton, KS. 67114
Board of Agriculture, Division of Water Resources
Application Number:

3 LOCATE WELL'S LOCATION WITH AN "X" IN SECTION BOX:


4 DEPTH OF COMPLETED WELL: 20' ft. ELEVATION:
Depth(s) Groundwater Encountered: 1. 12' ft. 2. _____ ft. 3. _____ ft.
WELL'S STATIC WATER LEVEL: 12.78' ft. below land surface measured on mo/day/yr 10-2-97
Pump test data: Well water was _____ ft. after _____ hours pumping _____ gpm
Est. Yield _____ gpm; Well water was _____ ft. after _____ hours pumping _____ gpm
Bore Hole Diameter: 8 1/2" in. to 20' ft., and _____ in. to _____ ft.
WELL WATER TO BE USED AS:
1 Domestic 3 Feedlot 6 Oil field water supply 8 Air conditioning 11 Injection well
2 Irrigation 4 Industrial 7 Lawn and garden only 10 Monitoring well 12 Other (Specify below)
Was a chemical/bacteriological sample submitted to Department? Yes _____ No X _____; If yes, mo/day/yr sample was submitted _____
Water Well Disinfected? Yes _____ No X _____

5 TYPE OF BLANK CASING USED:
1 Steel 3 RMP (SR) 5 Wrought iron 8 Concrete tile CASING JOINTS: Glued _____ Clamped _____
2 PVC 4 ABS 6 Asbestos-Cement 9 Other (specify below) Welded _____
Blank casing diameter 2.375 in. to 10' ft., Dia _____ in. to _____ ft., Dia _____ in. to SDR 13 ft.
Casing height above land surface Flush in., weight _____ lbs./ft. Wall thickness or gauge No. SCH. 40
TYPE OF SCREEN OR PERFORATION MATERIAL:
1 Steel 3 Stainless steel 5 Fiberglass 7 PVC 10 Asbestos-cement
2 Brass 4 Galvanized steel 6 Concrete tile 8 RMP (SR) 11 Other (specify) _____
12 None used (open hole)
SCREEN OR PERFORATION OPENINGS ARE:
1 Continuous slot 3 Mill slot 5 Gauzed wrapped 8 Saw cut 11 None (open hole)
2 Louvered shutter 4 Key punched 6 Wire wrapped 9 Drilled holes
7 Torch cut 10 Other (specify) _____
SCREEN-PERFORATED INTERVALS: From 20' ft. to 10' ft., From _____ ft. to _____ ft.
GRAVEL PACK INTERVALS: From 20' ft. to 8' ft., From _____ ft. to _____ ft.

6 GROUT MATERIAL: 1 Neat cement 2 Cement grout 3 Bentonite 4 Other
Grout intervals: From 8' ft. to 4' ft., From 4' ft. to 0' ft., From _____ ft. to _____ ft.
What is the nearest source of possible contamination:
1 Septic tank 4 Lateral lines 7 Pit privy 11 Fuel storage 14 Abandoned water well
2 Sewer lines 5 Cess pool 8 Sewage lagoon 12 Fertilizer storage 15 Oil well/Gas well
3 Watertight sewer lines 6 Seepage pit 9 Feedyard 13 Insecticide storage 16 Other (specify below)
Direction from well? East How many feet? 400'

FROM	TO	LITHOLOGIC LOG	FROM	TO	PLUGGING INTERVALS
0	6	Grass-dk brn to blk clay w/ root frag., tight, earthy odor.			
6	10	Tan-white sandy clay, moist, caliche stringers, no odor.			
10	11.5	Tan fine sand, moist-wet, no odor.			
11.5	20	Gray-green shaley clay w/ caliche & ls.rx. nodules, tight, dry, no odor.			

F.H. OK'd by Don Taylor
Waiver sent in w/ first wells

7 CONTRACTOR'S OR LANDOWNER'S CERTIFICATION: This water well was (1) constructed (2) reconstructed, or (3) plugged under my jurisdiction and was completed on (mo/day/year) 10-1-97 and this record is true to the best of my knowledge and belief. Kansas Water Well Contractor's License No. 539 This Water Well Record was completed on (mo/day/yr) 10-7-97 under the business name of JB Environmental Drilling by (signature) James Bieber

OFFICE USE ONLY
T
R
EW
SEC.
1/4
1/4
1/4