


1 LOCATION OF WATER WELL: County: Harvey Fraction: NW 1/4 SE 1/4 SE 1/4 Section Number: 20 Township Number: T 23 S Range Number: R 1 EW

Distance and direction from nearest town or city street address of well if located within city?
In town

2 WATER WELL OWNER: Phill Garrison
 RR#, St. Address, Box #: 1107 S. Washington Board of Agriculture, Division of Water Resources
 City, State, ZIP Code: Newton, Ks. 67114 Application Number:

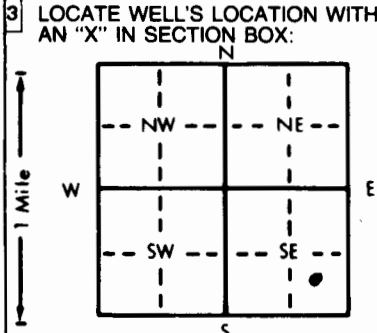

4 DEPTH OF COMPLETED WELL: 20' ft. ELEVATION:
 Depth(s) Groundwater Encountered 1. 12' ft. 2. ft. 3. ft.
 WELL'S STATIC WATER LEVEL: 12.89 ft. below land surface measured on 10-2-97
 Pump test data: Well water was ft. after hours pumping gpm
 Est. Yield gpm: Well water was ft. after hours pumping gpm
 Bore Hole Diameter: 8 1/2" in. to 20' ft., and in. to ft.
 WELL WATER TO BE USED AS:
 5 Public water supply 8 Air conditioning 11 Injection well
 1 Domestic 3 Feedlot 6 Oil field water supply 9 Dewatering 12 Other (Specify below)
 2 Irrigation 4 Industrial 7 Lawn and garden only 10 Monitoring well
 Was a chemical/bacteriological sample submitted to Department? Yes No X; If yes, mo/day/yr sample was submitted
 Water Well Disinfected? Yes No

5 TYPE OF BLANK CASING USED:
 1 Steel 3 RMP (SR) 5 Wrought iron 8 Concrete tile CASING JOINTS: Glued Clamped
2 PVC 4 ABS 6 Asbestos-Cement 9 Other (specify below) Welded
 7 Fiberglass Threaded X
 Blank casing diameter 2.375 in. to 10' ft., Dia. in. to ft., Dia. in. to SDR 13 ft.
 Casing height above land surface: Flush Mt. in., weight lbs./ft. Wall thickness or gauge No. SCH 40
 TYPE OF SCREEN OR PERFORATION MATERIAL:
 1 Steel 3 Stainless steel 5 Fiberglass 8 RMP (SR) 10 Asbestos-cement
 2 Brass 4 Galvanized steel 6 Concrete tile 9 ABS 11 Other (specify)
 12 None used (open hole)
 SCREEN OR PERFORATION OPENINGS ARE:
 1 Continuous slot 3 Mill slot 5 Gauzed wrapped 8 Saw cut 11 None (open hole)
 2 Louvered shutter 4 Key punched 6 Wire wrapped 9 Drilled holes
 7 Torch cut 10 Other (specify)
 SCREEN-PERFORATED INTERVALS: From 20' ft. to 10' ft., From ft. to ft.
 From ft. to ft., From ft. to ft.
 GRAVEL PACK INTERVALS: From 20' ft. to 8' ft., From ft. to ft.
 From ft. to ft., From ft. to ft.

6 GROUT MATERIAL:
 Grout Intervals: From 8' ft. to 4' ft., From 4' ft. to 0' ft., From ft. to ft.
 What is the nearest source of possible contamination:
 1 Septic tank 4 Lateral lines 7 Pit privy 10 Livestock pens 14 Abandoned water well
 2 Sewer lines 5 Cess pool 8 Sewage lagoon 11 Fuel storage 15 Oil well/Gas well
 3 Watertight sewer lines 6 Seepage pit 9 Feedyard 12 Fertilizer storage 16 Other (specify below)
 13 Insecticide storage
 Direction from well? East How many feet? 200'

FROM	TO	LITHOLOGIC LOG	FROM	TO	PLUGGING INTERVALS
0	.50	Asphalt			
.50	3	Dk brn-blk clay w/ some fine-coarse sand, dry, tight, no odor or plasticity.			
3	6	Red brn sandy clay w/ fine coarse qtz, ls. rx. grains, dry, tight, no odor.			
6	9	White-tan caliche w/ sand, dry, tight, no odor.			
9	17	White-tan fine-coarse sand, moist to wet at 11-12', no odor, well rounded & sorted.			
17	20	Gray shaley clay, dry, no odor.			

7 CONTRACTOR'S OR LANDOWNER'S CERTIFICATION: This water well was (1) constructed (2) reconstructed, or (3) plugged under my jurisdiction and was completed on (mo/day/year) 10-1-97 and this record is true to the best of my knowledge and belief. Kansas Water Well Contractor's License No. 539 This Water Well Record was completed on (mo/day/yr) 10-7-97 under the business name of Environmental Drilling by (signature) James Burke

OFFICE USE ONLY
T
R
EW
SEC.