


LOCATION OF WATER WELL: County: HARVEY Fraction: NW 1/4 SE 1/4 SW 1/4 Section Number: 5 Township Number: T 23 S Range Number: R 1 E/W

Distance and direction from nearest town or city street address of well if located within city? Regal crescent Drive
 WATER WELL OWNER: Millie Stucky
 RR#, St. Address, Box #: Box 352 Board of Agriculture, Division of Water Resources
 City, State, ZIP Code: North Newton, KS 67117 Application Number:

LOCATE WELL'S LOCATION WITH AN "X" IN SECTION BOX:

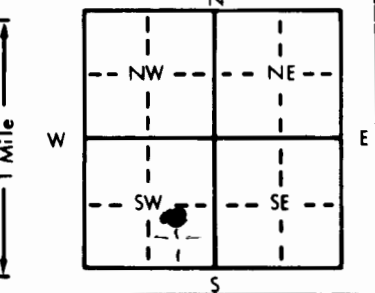

4 DEPTH OF COMPLETED WELL: 42 ft. ELEVATION:
 Depth(s) Groundwater Encountered 1. 15 ft. 2. ft. 3. ft.
 WELL'S STATIC WATER LEVEL: 14 ft. below land surface measured on mo/day/yr 4-20-83
 Pump test data: Well water was 42 ft. after 2 hours pumping 9 gpm
 Est. Yield 9 gpm: Well water was ft. after hours pumping gpm
 Bore Hole Diameter: 11 in. to 42 ft., and in. to ft.
 WELL WATER TO BE USED AS:
 5 Public water supply 8 Air conditioning 11 Injection well
 1 Domestic 3 Feedlot 6 Oil field water supply 9 Dewatering 12 Other (Specify below)
 2 Irrigation 4 Industrial 7 Lawn and garden only 10 Observation well
 Was a chemical/bacteriological sample submitted to Department? Yes No If yes, mo/day/yr sample was submitted
 Water Well Disinfected? Yes No

5 TYPE OF BLANK CASING USED:
 1 Steel 3 RMP (SR) 5 Wrought iron 8 Concrete tile CASING JOINTS: Glued Clamped
 2 PVC 4 ABS 6 Asbestos-Cement 9 Other (specify below) Welded
 7 Fiberglass Threaded
 Blank casing diameter 5 in. to 21 ft. Dia. in. to ft. Dia. in. to ft.
 Casing height above land surface 18 in., weight 2.37 lbs./ft. Wall thickness or gauge No. 0.214

TYPE OF SCREEN OR PERFORATION MATERIAL:
 1 Steel 3 Stainless steel 5 Fiberglass 8 RMP (SR) 11 Other (specify)
 2 Brass 4 Galvanized steel 6 Concrete tile 9 ABS 12 None used (open hole)

SCREEN OR PERFORATION OPENINGS ARE:
 1 Continuous slot 3 Mill slot 5 Gauzed wrapped 1025dot 8 Saw cut factory 11 None (open hole)
 2 Louvered shutter 4 Key punched 6 Wire wrapped 9 Drilled holes
 7 Torch cut 10 Other (specify)

SCREEN-PERFORATED INTERVALS: From 21 ft. to 31 ft., From ft. to ft.
 From 30 ft. to 42 ft., From ft. to ft.
 GRAVEL PACK INTERVALS: From 10 ft. to 42 ft., From ft. to ft.
 From ft. to ft., From ft. to ft.

6 GROUT MATERIAL: 1 Neat cement 2 Cement grout 3 Bentonite 4 Other
 Grout Intervals: From 0 ft. to 10 ft., From ft. to ft., From ft. to ft.
 What is the nearest source of possible contamination:
 1 Septic tank 4 Lateral lines 7 Pit privy 10 Livestock pens 14 Abandoned water well
 2 Sewer lines 5 Cess pool 8 Sewage lagoon 11 Fuel storage 15 Oil well/Gas well
 3 Watertight sewer lines 6 Seepage pit 9 Feedyard 12 Fertilizer storage 16 Other (specify below)
 13 Insecticide storage
 Direction from well? North How many feet? 175'

FROM	TO	LITHOLOGIC LOG	FROM	TO	LITHOLOGIC LOG
0	5	Fill sand & clay to loam			
5	10	red br. clay			
10	15	" " to hgt br. clay			
15	19	brown sandy clay			
19	23	Sand fine w/ chloride layers			
23	26	brown sandy clay			
26	29	Sand med course - grey clay			
29	31	green grey shale			
31	42	grey shale to cork			

7 CONTRACTOR'S OR LANDOWNER'S CERTIFICATION: This water well was (1) constructed, (2) reconstructed, or (3) plugged under my jurisdiction and was completed on (mo/day/year) 4-20-83 (pump 7/12/83) and this record is true to the best of my knowledge and belief. Kansas Water Well Contractor's License No. 175 This Water Well Record was completed on (mo/day/yr) 7/25/83 under the business name of Paul's Inc by signature Paul Bussler

INSTRUCTIONS: Use typewriter or ball point pen, PLEASE PRESS FIRMLY and PRINT clearly. Please fill in blanks, underline or circle the correct answers. Send top three copies to Kansas Department of Health and Environment, Division of Environment, Environmental Geology Section, Topeka, KS 66620. Send one to WATER WELL OWNER and retain one for your records.

OFFICE USE ONLY
T
R
E/W
SEC.
NW 1/4 SE 1/4 S W 1/4