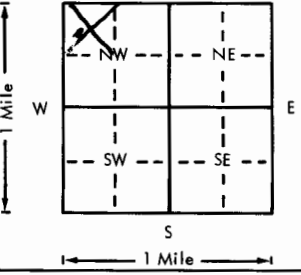


USE TYPEWRITER OR BALL POINT PEN-PRESS FIRMLY, PRINT CLEARLY.

WATER WELL RECORD
KSA 82a-1201-1215

Kansas Department of Health and Environment-Division of Environment
(Water well Contractors)
Topeka, Kansas 66620

1. Location of well: County <u>Harvey</u> Fraction <u>W1/4 NW1/4 NW1/4</u> Section number <u>2</u> Township number T <u>23</u> S R <u>1</u> EW	
2. Distance and direction from nearest town or city: <u>2 EAST on 24th ST and 3/4 N of Newton Kansas</u> Street address of well location if in city: <u>of Newton Kansas</u>	
3. Owner of well: <u>Cory Squawmin</u> R.R. or street: <u>R4</u> City, state, zip code: <u>Newton Kansas</u>	
4. Locate with "X" in section below: Sketch map: 	
6. Bore hole dia. <u>10 1/4</u> in. Completion date <u>9-4-76</u> Well depth <u>73</u> ft.	
7. <input checked="" type="checkbox"/> Cable tool <input type="checkbox"/> Rotary <input type="checkbox"/> Driven <input type="checkbox"/> Dug <input type="checkbox"/> Hollow rod <input type="checkbox"/> Jetted <input type="checkbox"/> Bored <input type="checkbox"/> Reverse rotary	
8. Use: <input type="checkbox"/> Domestic <input type="checkbox"/> Public supply <input type="checkbox"/> Industry <input type="checkbox"/> Irrigation <input type="checkbox"/> Air conditioning <input checked="" type="checkbox"/> Stock <input type="checkbox"/> Lawn <input type="checkbox"/> Oil field water <input type="checkbox"/> Other	
9. Casing: Material <u>Plastic</u> Height: Above or below <u>14</u> in. Threaded <input type="checkbox"/> Welded <input checked="" type="checkbox"/> Surface <u>14</u> in. RMP <input checked="" type="checkbox"/> PVC <input type="checkbox"/> Weight <u>200</u> lbs./ft. Dia <u>5</u> in. to <u>23</u> ft. depth Wall Thickness: inches or Dia. <u>5</u> in. to <u>23</u> ft. depth gage No. <u>2/1000</u>	
5. Type and color of material	
	From To
<u>Black soil</u>	0 6
<u>gray clay</u>	6 8
<u>Blue Shale</u>	8 30
<u>Sandy Loam</u>	30 40
<u>Blue Shale</u>	40 50
<u>Rack</u>	50 53
<u>Blue Shale</u>	53 73
10. Screen: Manufacturer's name <u>Sunflower</u> <u>Plastic pipe</u> Type <u>RMP</u> Dia. <u>5</u> Slot/gauze <u>2/32</u> Length <u>28</u> Set between <u>30</u> ft. and <u>40</u> ft. <u>50</u> ft. and <u>68</u> ft. Gravel pack? <input checked="" type="checkbox"/> Size range of material <u>1/2</u>	
11. Static water level: <u>24</u> ft. below land surface Date <u>9-4-76</u> mo./day/yr.	
12. Pumping level below land surfaces: <u>24</u> ft. after <u>30</u> hrs. pumping <u>20</u> g.p.m. <u> </u> ft. after <u> </u> hrs. pumping <u> </u> g.p.m. Estimated maximum yield <u>20</u> g.p.m.	
13. Water sample submitted: <input checked="" type="checkbox"/> Yes <input type="checkbox"/> No Date <u>9-4-76</u> mo./day/yr.	
14. Well head completion: <input type="checkbox"/> Pitless adapter <u>14</u> inches above grade	
15. Well grouted? <input checked="" type="checkbox"/> With: <input checked="" type="checkbox"/> Neat cement <input type="checkbox"/> Bentonite <input type="checkbox"/> Concrete Depth: From <u>0</u> ft. to <u>10</u> ft.	
16. Nearest source of possible contamination: ft. <u>150</u> Direction <u>E</u> Type <u>hangar</u> Well disinfected upon completion? <input checked="" type="checkbox"/> Yes <input type="checkbox"/> No	
17. Pump: <input checked="" type="checkbox"/> Not installed Manufacturer's name <u> </u> Model number <u> </u> HP <u> </u> Volts <u> </u> Length of drop pipe <u> </u> ft. capacity <u> </u> g.p.m. Type: <input type="checkbox"/> Submersible <input type="checkbox"/> Turbine <input type="checkbox"/> Jet <input type="checkbox"/> Reciprocating <input type="checkbox"/> Centrifugal <input type="checkbox"/> Other	
(Use a second sheet if needed)	
18. Elevation:	19. Remarks: <u>concrete slab by customer</u>
Topography: <input checked="" type="checkbox"/> Hill <input checked="" type="checkbox"/> Slope <input type="checkbox"/> Upland <input type="checkbox"/> Valley	20. Water well contractor's certification: This well was drilled under my jurisdiction and this report is true to the best of my knowledge and belief. <u>Frank Budd 221</u> Business name <u>Newton Kansas</u> License No. <u> </u> Address <u> </u> Signed <u>Frank Budd</u> Date <u> </u> Authorized representative

23 - 10 - 2
 Sec 1/4 NW 1/4