


USE TYPEWRITER OR BALL POINT PEN-PRESS FIRMLY, PRINT CLEARLY.

WATER WELL RECORD
KSA 82a-1201-1215

Kansas Department of Health and Environment-Division of Environment
(Water well Contractors)
Topeka, Kansas 66620

1. Location of well: County Harvey Fraction SE 1/4 SW 1/4 NW 1/4 Section number 5 Township number T 23 S R 1 Range number 6W

2. Distance and direction from nearest town or city: Street address of well location if in city: 13 Regal Crescent
3. Owner of well: Alvin Beachy
R.R. or street: 13 Regal Crescent
City, state, zip code: Newton Kansas

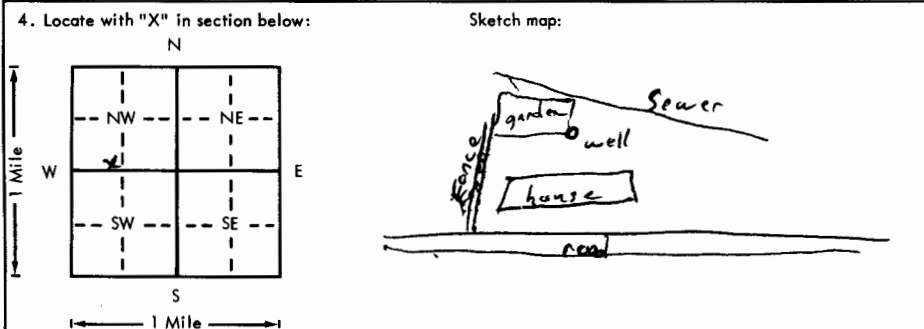

6. Bore hole dia. 1 1/2 in. Completion date 6/14/76
Well depth 39 ft.
7. Cable tool Rotary Driven Dug
 Hollow rod Jetted Bored Reverse rotary
8. Use: Domestic Public supply Industry
 Irrigation Air conditioning Stock
 Lawn Oil field water Other
9. Casing: Material plastic Height: above or below
Threaded Welded Surface 12 in.
RMP PVC Weight 5.25 lbs./ft.
Dia. 6 in. to 39 ft. depth Wall Thickness: inches or
Dia. in. to ft. depth gage No. 355

5. Type and color of material	From	To
<u>top soil</u>	<u>0</u>	<u>3</u>
<u>brown clay</u>	<u>3</u>	<u>15</u>
<u>gray clay</u>	<u>15</u>	<u>20</u>
<u>small sand</u>	<u>20</u>	<u>23</u>
<u>medium sand</u>	<u>23</u>	<u>28</u>
<u>blue shale</u>	<u>28</u>	<u>31</u>
<u>wellington shale</u>	<u>31</u>	<u>39</u>
(Use a second sheet if needed)		

10. Screen: Manufacturer's name Robin Tech own slot
Type PVC Dia. 6
Slot/gauze 10/64 Length 20
Set between 39 ft. and 19 ft.
ft. and 19 ft.
Gravel pack? yes Size range of material 1/8 to 1/4
11. Static water level: 13 ft. below land surface Date 6/2/76 mo./day/yr.
12. Pumping level below land surfaces:
12 ft. after 12 hrs. pumping 12 g.p.m.
19 ft. after 19 hrs. pumping 19 g.p.m.
Estimated maximum yield 12 gpm g.p.m.
13. Water sample submitted: 12 mo./day/yr.
 Yes No Date 6/2/76
14. Well head completion: well seal
 Pitless adapter 12 inches above grade
15. Well grouted? yes
With: Neat cement Bentonite Concrete
Depth: From 10 ft. to 0 ft.
16. Nearest source of possible contamination:
ft. 20 Direction south Type sewer
Well disinfected upon completion? Yes No
17. Pump: Not installed
Manufacturer's name Dempster
Model number DH3351 HP 1/2 Volts 115
Length of drop pipe 35 ft. capacity 12 g.p.m.
Type:
 Submersible Turbine
 Jet Reciprocating
 Centrifugal Other

18. Elevation: Topography: Hill Slope Upland Valley
19. Remarks: yard & garden irrigation

20. Water well contractor's certification:
This well was drilled under my jurisdiction and this report is true to the best of my knowledge and belief.
Pauls Inc 175
Business name License No.
Address Herston Kan 66545
Signed Paul Beachy Date 6/14/76
Authorized representative

T 23 S R 1 W 6 SE SW NW 1/4 1/4 1/4