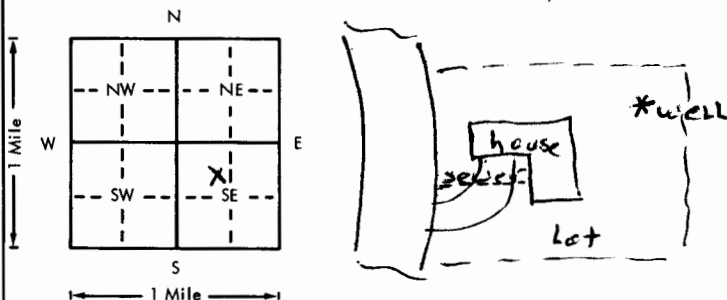


USE TYPEWRITER OR BALL POINT PEN-PRESS FIRMLY, PRINT CLEARLY.

WATER WELL RECORD  
KSA 82a-1201-1215

Kansas Department of Health and Environment-Division of Environment  
(Water well Contractors)  
Topeka, Kansas 66620

1. Location of well:		County <b>HARVEY</b>	Fraction <b>SE 1/4 NW 1/4 SE 1/4</b>	Section number <b>5</b>	Township number <b>T 23 S R 1 E/W</b>	Range number <b>1 E/W</b>
2. Distance and direction from nearest town or city: Street address of well location if in city: <b>#7 JASPER COURT N. NEWTON, KANSAS</b>			3. Owner of well: <b>WALDO Kaufman</b> R.R. or street: City, state, zip code: <b>HENDERSON, Neb.</b>			
4. Locate with "X" in section below: Sketch map: 			6. Bore hole dia. <b>12</b> in. Completion date <b>6/15/76</b> Well depth <b>39</b> ft.			
5. Type and color of material			From	To	7. <input type="checkbox"/> Cable tool <input checked="" type="checkbox"/> Rotary <input type="checkbox"/> Driven <input type="checkbox"/> Dug <input type="checkbox"/> Hollow rod <input type="checkbox"/> Jetted <input type="checkbox"/> Bored <input type="checkbox"/> Reverse rotary	
top Loam			0	2	8. Use: <input type="checkbox"/> Domestic <input type="checkbox"/> Public supply <input type="checkbox"/> Industry <input type="checkbox"/> Irrigation <input type="checkbox"/> Air conditioning <input type="checkbox"/> Stock <input checked="" type="checkbox"/> Lawn <input type="checkbox"/> Oil field water <input type="checkbox"/> Other	
grey clay → BROWN CLAY			2	13	9. Casing: Material <u>plastic</u> Height: Above or below Threaded <input type="checkbox"/> Welded <input checked="" type="checkbox"/> Surface <u>12"</u> in. RMP <input type="checkbox"/> PVC <input checked="" type="checkbox"/> Weight <u>3.23</u> lbs./ft. Dia. <u>6</u> in. to <u>39</u> ft. depth Wall Thickness: inches or Dia. <u>   </u> in. to <u>   </u> ft. depth gage No. <u>2255</u>	
hard Limestone			13	22	10. Screen: Manufacturer's name <u>Robinter - own slot</u> Type <u>PVC</u> Dia. <u>6"</u> Slot/gauze <u>0.64</u> Length <u>20'</u> Set between <u>15</u> ft. and <u>35</u> ft. ft. and <u>   </u> ft. Gravel pack? <u>yes</u> Size range of material <u>1/8-1/4</u>	
SAND + clay			22	23	11. Static water level: <u>14</u> ft. below land surface Date <u>6/15/76</u> mo./day/yr.	
grey clay			23	26	12. Pumping level below land surfaces: <u>33</u> ft. after <u>1</u> hrs. pumping <u>12</u> g.p.m. <u>   </u> ft. after <u>   </u> hrs. pumping <u>   </u> g.p.m. Estimated maximum yield <u>12</u> g.p.m.	
SAND + CLAY			26	28	13. Water sample submitted: <u>   </u> mo./day/yr. Yes <input checked="" type="checkbox"/> No <input type="checkbox"/> Date <u>   </u>	
BLUE SHALE			28	30	14. Well head completion: <input type="checkbox"/> Pitless adapter <u>12"</u> inches above grade	
MEDIUM SAND			30	32	15. Well grouted? <u>yes</u> With: <input type="checkbox"/> Neat cement <input checked="" type="checkbox"/> Bentonite <input type="checkbox"/> Concrete Depth: From <u>10</u> ft. to <u>6</u> ft.	
WELLINGTON SHALE			32	33	16. Nearest source of possible contamination: ft. <u>57</u> Direction <u>west</u> Type <u>sewer</u> Well disinfected upon completion? <input type="checkbox"/> Yes <input checked="" type="checkbox"/> No	
(Use a second sheet if needed)					17. Pump: <input checked="" type="checkbox"/> Not installed Manufacturer's name <u>   </u> Model number <u>   </u> HP <u>   </u> Volts <u>   </u> Length of drop pipe <u>   </u> ft. capacity <u>   </u> g.p.m. Type: <input type="checkbox"/> Submersible <input type="checkbox"/> Turbine <input type="checkbox"/> Jet <input type="checkbox"/> Reciprocating <input type="checkbox"/> Centrifugal <input type="checkbox"/> Other	
18. Elevation:		19. Remarks:		20. Water well contractor's certification: This well was drilled under my jurisdiction and this report is true to the best of my knowledge and belief. <u>PAUL'S INC</u> # <u>175</u> Business name License No. Address <u>HESSTON, KNS</u> Signed <u>Paul Bandhut</u> Date <u>6/15/76</u> Authorized representative		

23 - 10 - 5 SE W 5 E  
T  
R  
Sec  
1/4  
1/4  
1/4