


Copy - HP

1 LOCATION OF WATER WELL: County: **Harvey** Fraction: **nw 1/4 SE 1/4 SW 1/4** Section Number: **5** Township Number: **T 23 S** Range Number: **R 10 EW**

Distance and direction from nearest town or city street address of well if located within city? **205 W 27th**

2 WATER WELL OWNER: **Eldon Bargaen** RR#, St. Address, Box #: **205 W 27th** City, State, ZIP Code: **Newton, Ks 67114** Board of Agriculture, Division of Water Resources Application Number:

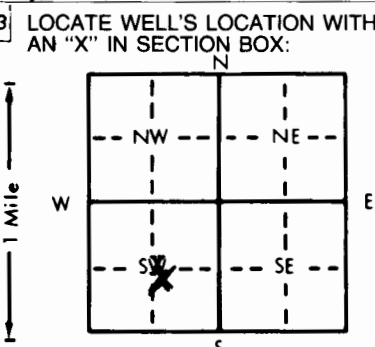

4 DEPTH OF COMPLETED WELL: **43** ft. ELEVATION: Depth(s) Groundwater Encountered 1. ft. 2. ft. 3. ft. WELL'S STATIC WATER LEVEL: **19** ft. below land surface measured on mo/day/yr **7-17-83** Pump test data: Well water was **28** ft. after **1** hours pumping **4** gpm Est. Yield **4** gpm Well water was ft. after hours pumping gpm Bore Hole Diameter: **10** in. to **30** ft., and **5** in. to **43** ft. WELL WATER TO BE USED AS: 5 Public water supply  Air conditioning 11 Injection well 1 Domestic 3 Feedlot 6 Oil field water supply 9 Dewatering 12 Other (Specify below) 2 Irrigation 4 Industrial 7 Lawn and garden only 10 Observation well Was a chemical/bacteriological sample submitted to Department? Yes No ; If yes, mo/day/yr sample was submitted Water Well Disinfected? Yes  No

5 TYPE OF BLANK CASING USED: 1 Steel 3 RMP (SR) 5 Wrought iron 8 Concrete tile CASING JOINTS: Glued  Clamped 2 Brass 4 Galvanized steel 6 Asbestos-Cement 9 Other (specify below) Welded 3 Stainless steel 7 Fiberglass Threaded  PVC 10 Asbestos-cement 11 Other (specify) 12 None used (open hole) Blank casing diameter: **6** in. to **20** ft., Dia. in. to ft., Dia. in. to ft. Casing height above land surface: **12** in., weight **3.25** lbs./ft. Wall thickness or gauge No. TYPE OF SCREEN OR PERFORATION MATERIAL: 1 Steel 3 Stainless steel 5 Fiberglass 8 RMP (SR) 11 Other (specify) 2 Brass 4 Galvanized steel 6 Concrete tile 9 ABS 12 None used (open hole) SCREEN OR PERFORATION OPENINGS ARE: 5 Gauzed wrapped  Saw cut 11 None (open hole) 1 Continuous slot 3 Mill slot 6 Wire wrapped 9 Drilled holes 2 Louvered shutter 4 Key punched 7 Torch cut 10 Other (specify) SCREEN-PERFORATED INTERVALS: From **20** ft. to **30** ft., From ft. to ft. GRAVEL PACK INTERVALS: From **15** ft. to **30** ft., From ft. to ft.

6 GROUT MATERIAL:  Neat cement 2 Cement grout 3 Bentonite 4 Other Grout Intervals: From **3** ft. to **15** ft., From ft. to ft., From ft. to ft. What is the nearest source of possible contamination: 1 Septic tank 4 Lateral lines 7 Pit privy 10 Livestock pens 14 Abandoned water well 2 Sewer lines 5 Cess pool 8 Sewage lagoon 11 Fuel storage 15 Oil well/Gas well  Watertight sewer lines 6 Seepage pit 9 Feedyard 12 Fertilizer storage 16 Other (specify below) 13 Insecticide storage Direction from well? **12 W** How many feet? **12**

FROM	TO	LITHOLOGIC LOG	FROM	TO	LITHOLOGIC LOG
0	11	Br Clay			
11	13	Gray Clay			
13	18	Silty Sand + Sm Gravel			
18	22	Gr Clay			
22	26	F + G Sand - Silt			
26	28	Gr Clay			
28	43	Gray Shale			

7 CONTRACTOR'S OR LANDOWNER'S CERTIFICATION: This water well was **(1)** constructed, (2) reconstructed, or (3) plugged under my jurisdiction and was completed on (mo/day/year) **7-28-83** and this record is true to the best of my knowledge and belief. Kansas Water Well Contractor's License No. **447** This Water Well Record was completed on (mo/day/yr) **1-19-84** under the business name of **Miller Drilling** by (signature) *Eg Miller*

INSTRUCTIONS: Use typewriter or ball point pen, PLEASE PRESS FIRMLY and PRINT clearly. Please fill in blanks underline or circle the correct answers. Send top three copies to Kansas Department of Health and Environment, Division of Environment, Environmental Geology Section, Topeka, KS 66620. Send one to WATER WELL OWNER and retain one for your records.

OFFICE USE ONLY  
T  
R  
EW  
SEC  
1/4  
1/4  
1/4  
1/4  
1/4