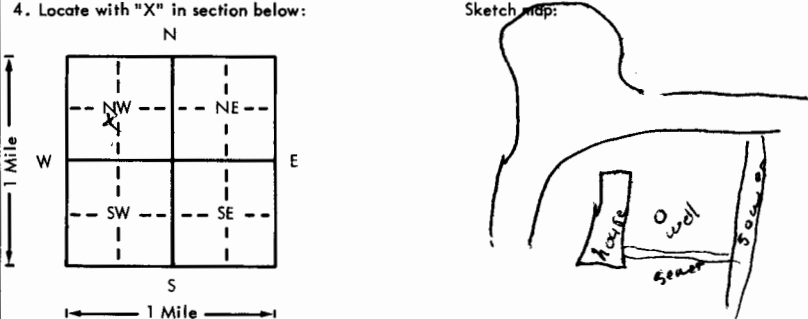


USE TYPEWRITER OR BALL POINT PEN-PRESS FIRMLY, PRINT CLEARLY.

WATER WELL RECORD  
KSA 82a-1201-1215

Kansas Department of Health and Environment-Division of Environment  
(Water well Contractors)  
Topeka, Kansas 66620

1. Location of well:		County: <u>Haskell</u>	Fraction: <u>NE 1/4 SW 1/4 NW 1/4</u>	Section number: <u>5</u>	Township number: <u>T 23 S R 1</u>	Range number: <u>6W</u>
2. Distance and direction from nearest town or city: Street address of well location if in city: <u>Same</u>			3. Owner of well: <u>Virgil Penner</u> R.R. or street: <u>28 Royal Crescent</u> City, state, zip code: <u>N. Newton Kansas</u>			
4. Locate with "X" in section below: 			6. Bore hole dia. <u>6</u> in. Completion date: <u>6-8-76</u> Well depth: <u>39</u> ft.			
5. Type and color of material			7. <input type="checkbox"/> Cable tool <input checked="" type="checkbox"/> Rotary <input type="checkbox"/> Driven <input type="checkbox"/> Dug <input type="checkbox"/> Hollow rod <input type="checkbox"/> Jetted <input type="checkbox"/> Bored <input type="checkbox"/> Reverse rotary			
			8. Use: <input type="checkbox"/> Domestic <input type="checkbox"/> Public supply <input type="checkbox"/> Industry <input checked="" type="checkbox"/> Irrigation <input type="checkbox"/> Air conditioning <input type="checkbox"/> Stock <input checked="" type="checkbox"/> Lawn <input type="checkbox"/> Oil field water <input type="checkbox"/> Other			
			9. Casing: Material <u>plastic</u> Height: <u>Above</u> or below Threaded <input type="checkbox"/> Welded <input checked="" type="checkbox"/> Surface <u>12</u> in. RMP <input type="checkbox"/> PVC <input checked="" type="checkbox"/> Weight <u>323</u> lbs./ft. Dia <u>6</u> in. to <u>39</u> ft. depth Wall Thickness: inches or Dia. <u>  </u> in. to <u>  </u> ft. depth Gauge No. <u>255</u>			
			10. Screen: Manufacturer's name <u>Babin Tech</u> Type <u>P.V.C.</u> Dia. <u>6</u> Slot/gauze <u>10/64</u> Length <u>20</u> Set between <u>39</u> ft. and <u>19</u> ft. Gravel pack? <input checked="" type="checkbox"/> Size range of material <u>1/8 to 1/4</u>			
			11. Static water level: <u>14</u> ft. below land surface Date <u>6/8/76</u>			
			12. Pumping level below land surfaces: <u>  </u> ft. after <u>  </u> hrs. pumping <u>10</u> g.p.m. <u>  </u> ft. after <u>  </u> hrs. pumping <u>  </u> g.p.m. Estimated maximum yield <u>10</u> g.p.m.			
			13. Water sample submitted: <u>  </u> mo./day/yr. <input type="checkbox"/> Yes <input checked="" type="checkbox"/> No Date <u>  </u>			
			14. Well head completion: <input type="checkbox"/> Pitless adapter <u>12</u> Inches above grade			
			15. Well grouted? <input checked="" type="checkbox"/> <u>yes</u> With: <input checked="" type="checkbox"/> Neat cement <input type="checkbox"/> Bentonite <input type="checkbox"/> Concrete Depth: From <u>10</u> ft. to <u>0</u> ft.			
			16. Nearest source of possible contamination: ft. <u>20</u> Direction <u>South</u> Type <u>Sewer</u> Well disinfected upon completion? <input type="checkbox"/> Yes <input checked="" type="checkbox"/> No			
			17. Pump: <input checked="" type="checkbox"/> Not installed Manufacturer's name <u>  </u> Model number <u>  </u> HP <u>  </u> Volts <u>  </u> Length of drop pipe <u>  </u> ft. capacity <u>  </u> g.p.m. Type: <input type="checkbox"/> Submersible <input type="checkbox"/> Turbine <input type="checkbox"/> Jet <input type="checkbox"/> Reciprocating <input type="checkbox"/> Centrifugal <input type="checkbox"/> Other			
18. Elevation:			20. Water well contractor's certification: This well was drilled under my jurisdiction and this report is true to the best of my knowledge and belief. <u>Pauls Inc.</u> License No. <u>175</u> Business name <u>Herston Kansas</u> License No. <u>27062</u> Address <u>  </u> Signed <u>Paul B...</u> Date <u>  </u> Authorized representative			
19. Remarks:						
Topography: <input type="checkbox"/> Hill <input type="checkbox"/> Slope <input checked="" type="checkbox"/> Upland <input type="checkbox"/> Valley						

T 23 S R 1 W 6 NE SW NW