

USE TYPEWRITER OR BALL POINT PEN-PRESS FIRMLY, PRINT CLEARLY.


T R EW sec 1/4 1/4 1/4 No.

WATER WELL RECORD
KSA 82a-1201-1215

Kansas State Dept. Of Health
(Water Well Contractors)
Forbes-Bldg. 740
Topeka, Kansas 66620

1 Location of well: County HARVEY Township name Newton Fraction SE 1/4 / SW 1/4 Section number 5 Town number T-23-S Range number R-7-E

Distance and direction from nearest town or city: _____ 3 Owner of well: Bill Freisen
Street address of well location if in city: 304 W 24th N. Newton Address: 304 W 24th N. Newton, KNS

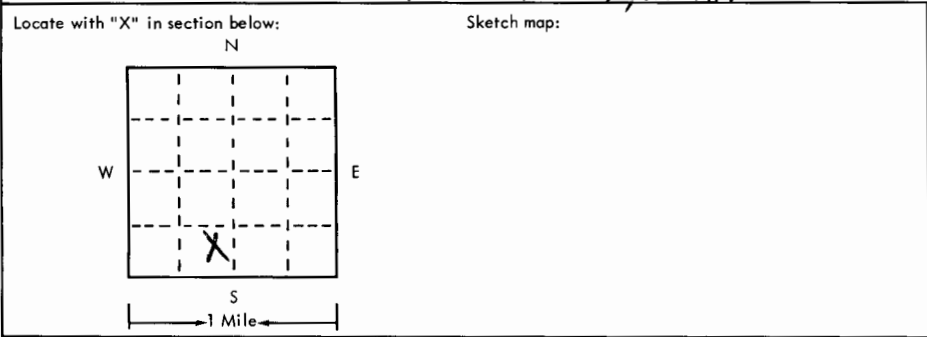

4 Well depth: 41 ft. Date of completion 5/22/75
Well diameter 12 1/4 in.
5 Cable tool Rotary Driven Dug
 Hollow rod Jetted Bored Reverse rotary
6 Use: Domestic Public supply Industry
ye: Irrigation Air conditioning Commercial
 Test well _____
7 Casing: Material Styrene Weight: (above) below
Threaded Welded Surface 2 in.
Diam. _____ Weight _____ lbs./ft. _____
6 in. to 41 ft. depth Drive shoe? Yes No
_____ in. to _____ ft. depth

2	Type and color of material	From	To
	<u>Loam - Sandy</u>	<u>0</u>	<u>5</u>
	<u>Sandy loam to clay</u>	<u>5</u>	<u>10</u>
	<u>clay brown</u>	<u>10</u>	<u>22</u>
	<u>SANDY clay</u>	<u>22</u>	<u>23</u>
	<u>gray clay</u>	<u>23</u>	<u>26</u>
	<u>SAND (Med coarse) and clay</u>	<u>26</u>	<u>35</u>
	<u>dark clay</u>	<u>35</u>	<u>38</u>
	<u>gray-green - Shale</u>	<u>38</u>	<u>40</u>
	<u>dark Shale</u>	<u>40</u>	<u>41</u>
	(use a second sheet if needed)		

8 Screen: Manufacturer Jetstream
Type STYRENE Dia. 6 in.
Slot/gauze 1/8 Length 20 ft.
Set between 20 ft. and 40 ft.
Fittings: 1/8 to 3/8 in.
Gravel pack Yes No Size range of material _____
9 Static water level: 12 ft. below land surface Date 5/22/75
10 Pumping level below land surfaces:
26 ft. after 1 hrs. pumping 20 g.p.m.
_____ ft. after _____ hrs. pumping _____ g.p.m.
Estimated maximum yield 20 g.p.m.
11 Water sample submitted: Yes No Date _____
12 Well head completion: Pitless adapter Inches above grade
13 Well grouted? Yes No
 Neat cement Bentonite _____
Depth: From 10 ft. to 0 ft.
14 Nearest source of possible contamination: Barn yd
ft. 40 Direction EAST Type _____
Well disinfected upon completion? Yes No
15 Pump: Not installed
Manufacturer's name _____
Model number _____ HP _____ Volts _____
Length of drop pipe _____ ft. capacity _____ g.p.m.
Type: Submersible Turbine
 Jet Reciprocating
 Centrifugal Other

16 Remarks: elevation
Topography: Hill Slope Upland Valley

17 Water well contractor's certification:
This well was drilled under my jurisdiction and this report is true to the best of my knowledge and belief.
PAUL'S INC #175
Business name License No.
Address Box 26 Newton, KNS
Signed Paul Paul Date 5/22/75
(Authorized Representative)