


1 LOCATION OF WATER WELL: Fraction Ne 1/4 Se 1/4 Me 1/4 Section Number 5 Township Number T 23 S Range Number R 1 E/W
 County: Harvey

Distance and direction from nearest town or city street address of well if located within city?
in city N. Newton 308 Campus Ct.

2 WATER WELL OWNER: Maples Preheim Board of Agriculture, Division of Water Resources
 RR#, St. Address, Box #: 308 Campus Ct. Application Number:
 City, State, ZIP Code: N. Newton, Ks. 67117

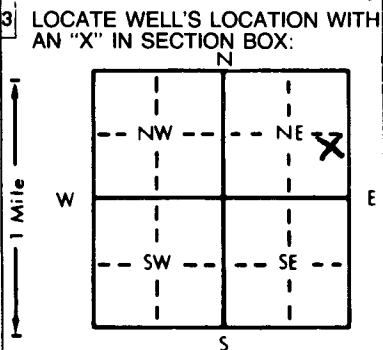

4 DEPTH OF COMPLETED WELL: 96 ft. ELEVATION:
 Depth(s) Groundwater Encountered 1. 13 ft. 2. 25 ft. 3. 72 ft.
 WELL'S STATIC WATER LEVEL 13 ft. below land surface measured on 8-6-92 mo/day/yr
 Pump test data: Well water was 15 gpm after 7 1/2 hours pumping 96 gpm
 Est. Yield 15 gpm Well water was 25 ft. after 7 1/2 hours pumping 96 gpm
 Bore Hole Diameter 9 in. to 25 ft., and 7 1/2 in. to 96 ft.
 WELL WATER TO BE USED AS:
 5 Public water supply 8 Air conditioning 11 Injection well
 1 Domestic 3 Feedlot 6 Oil field water supply 9 Dewatering 12 Other (Specify below)
 2 Irrigation 4 Industrial 7 Lawn and garden only 10 Monitoring well
 Was a chemical/bacteriological sample submitted to Department? Yes X No X; If yes, mo/day/yr sample was submitted
 Water Well Disinfected? Yes X No

5 TYPE OF BLANK CASING USED:
 1 Steel 3 RMP (SR) 5 Wrought iron 8 Concrete tile CASING JOINTS: Glued X Clamped
 2 PVC 4 ABS 6 Asbestos-Cement 9 Other (specify below) Welded
 7 Fiberglass Threaded
 Blank casing diameter 5 in. to 76 ft., Dia. CLASS 160 in. to 214 ft., Dia. 214 in. to 214 ft.
 Casing height above land surface 12 in., weight CLASS 160 lbs./ft. Wall thickness or gauge No. 214
 TYPE OF SCREEN OR PERFORATION MATERIAL:
 1 Steel 3 Stainless steel 5 Fiberglass 7 PVC 10 Asbestos-cement
 2 Brass 4 Galvanized steel 6 Concrete tile 8 RMP (SR) 11 Other (specify)
 9 ABS 12 None used (open hole)
 SCREEN OR PERFORATION OPENINGS ARE:
 1 Continuous slot 3 Mill slot 5 Gauzed wrapped 8 Saw cut 11 None (open hole)
 2 Louvered shutter 4 Key punched 6 Wire wrapped 9 Drilled holes
 7 Torch cut 10 Other (specify)

6 GROUT MATERIAL: 1 Neat cement 2 Cement grout 3 Bentonite 4 Other
 What is the nearest source of possible contamination:
 1 Septic tank 4 Lateral lines 7 Pit privy 10 Livestock pens 14 Abandoned water well
 2 Sewer lines 5 Cess pool 8 Sewage lagoon 11 Fuel storage 15 Oil well/Gas well
 3 Watertight sewer lines 6 Seepage pit 9 Feedyard 12 Fertilizer storage 16 Other (specify below)
 13 Insecticide storage
 Direction from well? S How many feet? 30

FROM	TO	LITHOLOGIC LOG	FROM	TO	PLUGGING INTERVALS
<u>0</u>	<u>23</u>	<u>Clay</u>			
<u>23</u>	<u>26</u>	<u>Sandy Clay</u>			
<u>26</u>	<u>35</u>	<u>Gray Shale</u>			
<u>35</u>	<u>89</u>	<u>Blue + Gray Shale</u>			
<u>89</u>	<u>89</u>	<u>Water</u>			
<u>89</u>	<u>96</u>	<u>Gray Shale</u>			

7 CONTRACTOR'S OR LANDOWNER'S CERTIFICATION: This water well was (1) constructed (2) reconstructed, or (3) plugged under my jurisdiction and was completed on (mo/day/year) 8-6-92 and this record is true to the best of my knowledge and belief. Kansas Water Well Contractor's License No. 180 This Water Well Record was completed on (mo/day/year) 8-14-92 under the business name of Backhus Drilling by (signature) Paul H. Backhus

OFFICE USE ONLY
T
R
EW
SEC
1/4
1/4
1/4