


1 LOCATION OF WATER WELL: County: HARVEY Fraction: SW 1/4 SE 1/4 SW 1/4 Section Number: 7 Township Number: T 23 S Range Number: R 1E EW

Distance and direction from nearest town or city street address of well if located within city?  
1321 GRAND OXFORD

2 WATER WELL OWNER: MARVIN MILLER  
 RR#, St. Address, Box #: 1321 GRAND OXFORD Board of Agriculture, Division of Water Resources  
 City, State, ZIP Code: NEWTON KS 67114 Application Number:

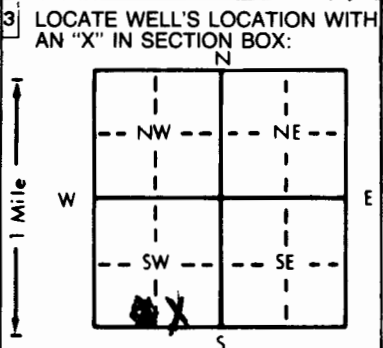

4 DEPTH OF COMPLETED WELL: 52 ft. ELEVATION: Flat  
 Depth(s) Groundwater Encountered: 1 25 ft. 2. . . . . ft. 3. . . . . ft.  
 WELL'S STATIC WATER LEVEL: 1.2 ft. below land surface measured on mo/day/yr 4-16-92  
 Pump test data: Well water was 30 ft. after 3 hours pumping 20 gpm  
 Est. Yield: 20 gpm; Well water was . . . . . ft. after . . . . . hours pumping . . . . . gpm  
 Bore Hole Diameter: 9 in. to 5.2 ft., and . . . . . in. to . . . . . ft.  
 WELL WATER TO BE USED AS:  
 5 Public water supply 8 Air conditioning 11 Injection well  
 1 Domestic 3 Feedlot 6 Oil field water supply 9 Dewatering 12 Other (Specify below)  
 2 Irrigation 4 Industrial  Lawn and garden only 10 Monitoring well  
 Was a chemical/bacteriological sample submitted to Department? Yes. . . . . No. X; If yes, mo/day/yr sample was submitted  
 Water Well Disinfected?  Yes  No

5 TYPE OF BLANK CASING USED:  
 1 Steel 3 RMP (SR) 5 Wrought iron 8 Concrete tile CASING JOINTS: Glued X Clamped . . . . .  
 PVC 4 ABS 6 Asbestos-Cement 9 Other (specify below) Welded . . . . .  
 7 Fiberglass . . . . . Threaded . . . . .  
 Blank casing diameter: 5 in. to 5.2 ft., Dia. . . . . in. to . . . . . ft., Dia. . . . . in. to . . . . . ft.  
 Casing height above land surface: 20 in., weight 2.89 lbs./ft. Wall thickness or gauge No. 0.014  
 TYPE OF SCREEN OR PERFORATION MATERIAL:  
 1 Steel 3 Stainless steel 5 Fiberglass 8 RMP (SR) 10 Asbestos-cement  
 2 Brass 4 Galvanized steel 6 Concrete tile 9 ABS 11 Other (specify) . . . . .  
 12 None used (open hole)  
 SCREEN OR PERFORATION OPENINGS ARE:  
 1 Continuous slot 3 Mill slot 5 Gauzed wrapped  Saw cut 11 None (open hole)  
 2 Louvered shutter 4 Key punched 6 Wire wrapped 9 Drilled holes  
 7 Torch cut 10 Other (specify) . . . . .  
 SCREEN-PERFORATED INTERVALS: From 40 ft. to 50 ft., From . . . . . ft. to . . . . . ft.  
 From . . . . . ft. to . . . . . ft., From . . . . . ft. to . . . . . ft.  
 GRAVEL PACK INTERVALS: From 10 ft. to 50 ft., From . . . . . ft. to . . . . . ft.  
 From . . . . . ft. to . . . . . ft., From . . . . . ft. to . . . . . ft.

6 GROUT MATERIAL: 1 Neat cement 2 Cement grout  Bentonite 4 Other . . . . .  
 Grout Intervals: From 0 ft. to 12 ft., From . . . . . ft. to . . . . . ft., From . . . . . ft. to . . . . . ft.  
 What is the nearest source of possible contamination:  
 1 Septic tank 4 Lateral lines 7 Pit privy 10 Livestock pens 14 Abandoned water well  
 2 Sewer lines 5 Cess pool 8 Sewage lagoon 11 Fuel storage 15 Oil well/Gas well  
 Watertight sewer lines 6 Seepage pit 9 Feedyard 12 Fertilizer storage 16 Other (specify below)  
 13 Insecticide storage  
 Direction from well? WEST How many feet? 100

FROM	TO	LITHOLOGIC LOG	FROM	TO	PLUGGING INTERVALS
0	30	CLAY			
30	48	COARSE SAND			
48	52	SHALE			

7 CONTRACTOR'S OR LANDOWNER'S CERTIFICATION: This water well was  constructed, (2) reconstructed, or (3) plugged under my jurisdiction and was completed on (mo/day/year) 4-16-92 and this record is true to the best of my knowledge and belief. Kansas Water Well Contractor's License No. 362 This Water Well Record was completed on (mo/day/yr) 12-28-92 under the business name of MARTIN SUPPLY by (signature) Burt Schmitt

OFFICE USE ONLY  
T  
R  
EW  
SEC.  
1/4  
1/4  
1/4